
A0

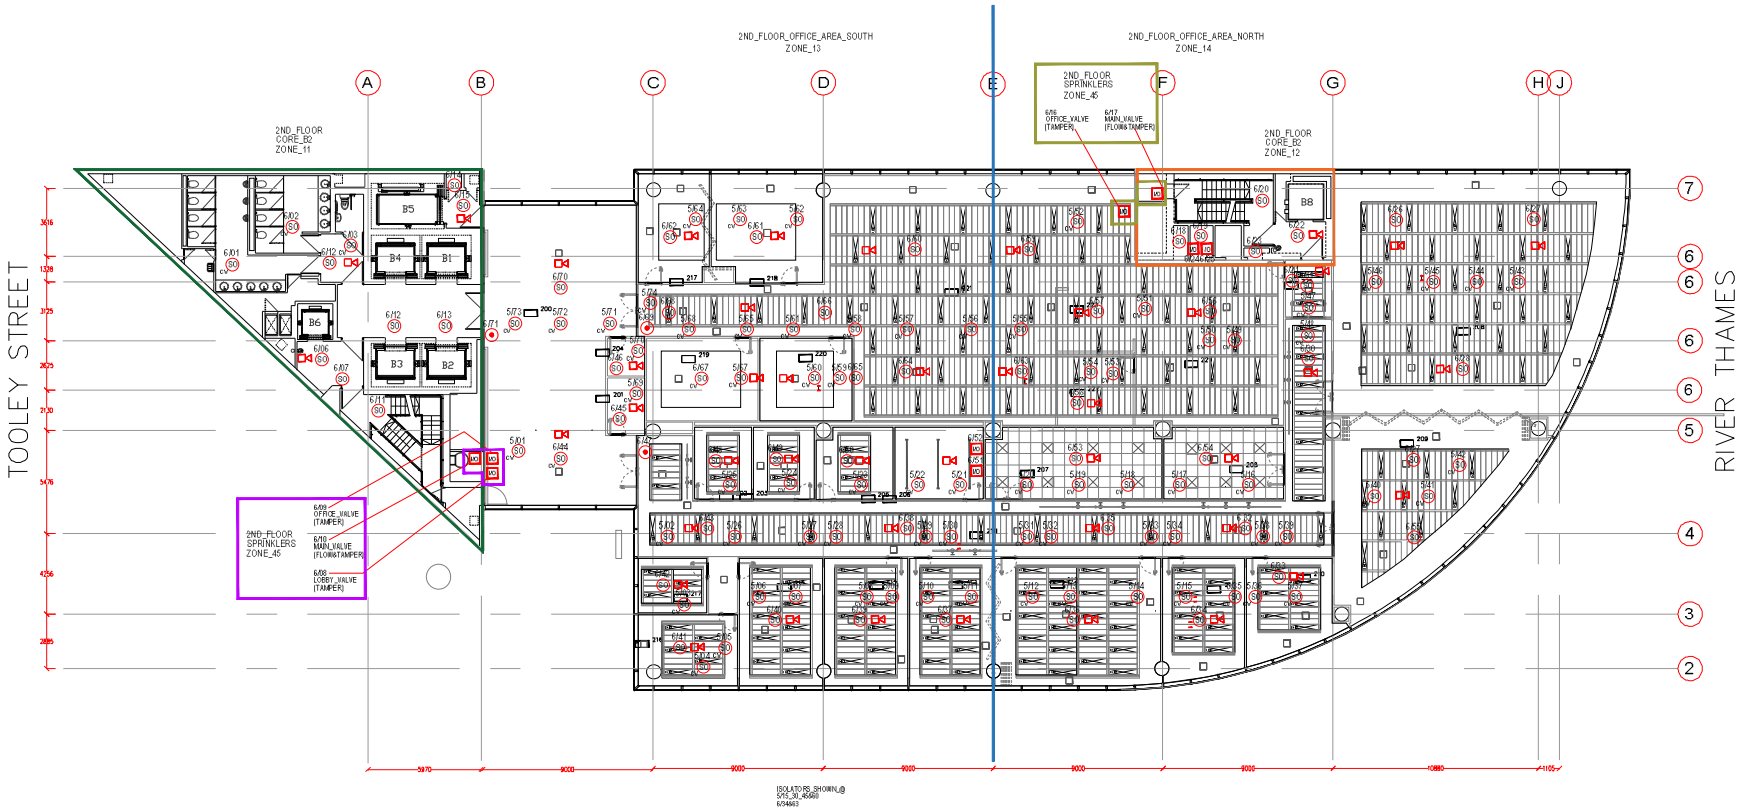

THIS DRAWING IS ISSUED UPON THE UNDERSTANDING THAT THE INFORMATION SHOWN THEREON SHALL NOT BE COPIED OR DISCLOSED TO A THIRD PARTY WITHOUT THE WRITTEN CONSENT OF BTE SYSTEMS LTD

LEGEND:

- SMOKE DETECTOR
- HEAT DETECTOR
- DUCT DETECTOR
- SPEAKER
- MANUAL CALL POINT
- CV CEILING VOID

REV	DATE	APP. BY	REVISION DETAILS
A	01.11.17	W.B.	AS_INSTALLED

BTE SYSTEMS
FIRE RISK MANAGEMENT
113 FORDBRIDGE ROAD
ASHFORD
MIDDLESEX TW15 3RZ
TEL: 01784 250977 FAX: 01784 250976

PROJECT:
2 More London Riverside . London

TITLE:
2nd Floor . Fire Alarm System

STATUS:
AS INSTALLED

SCALE: 1:100@A0 DATE: 31.10.17

DRAWN: LHR APPROVED BY W.B.

DWG NO:
BTES-2MPL-414-FA-02

2ND FLOOR REFLECTED CEILING PLAN