
A0

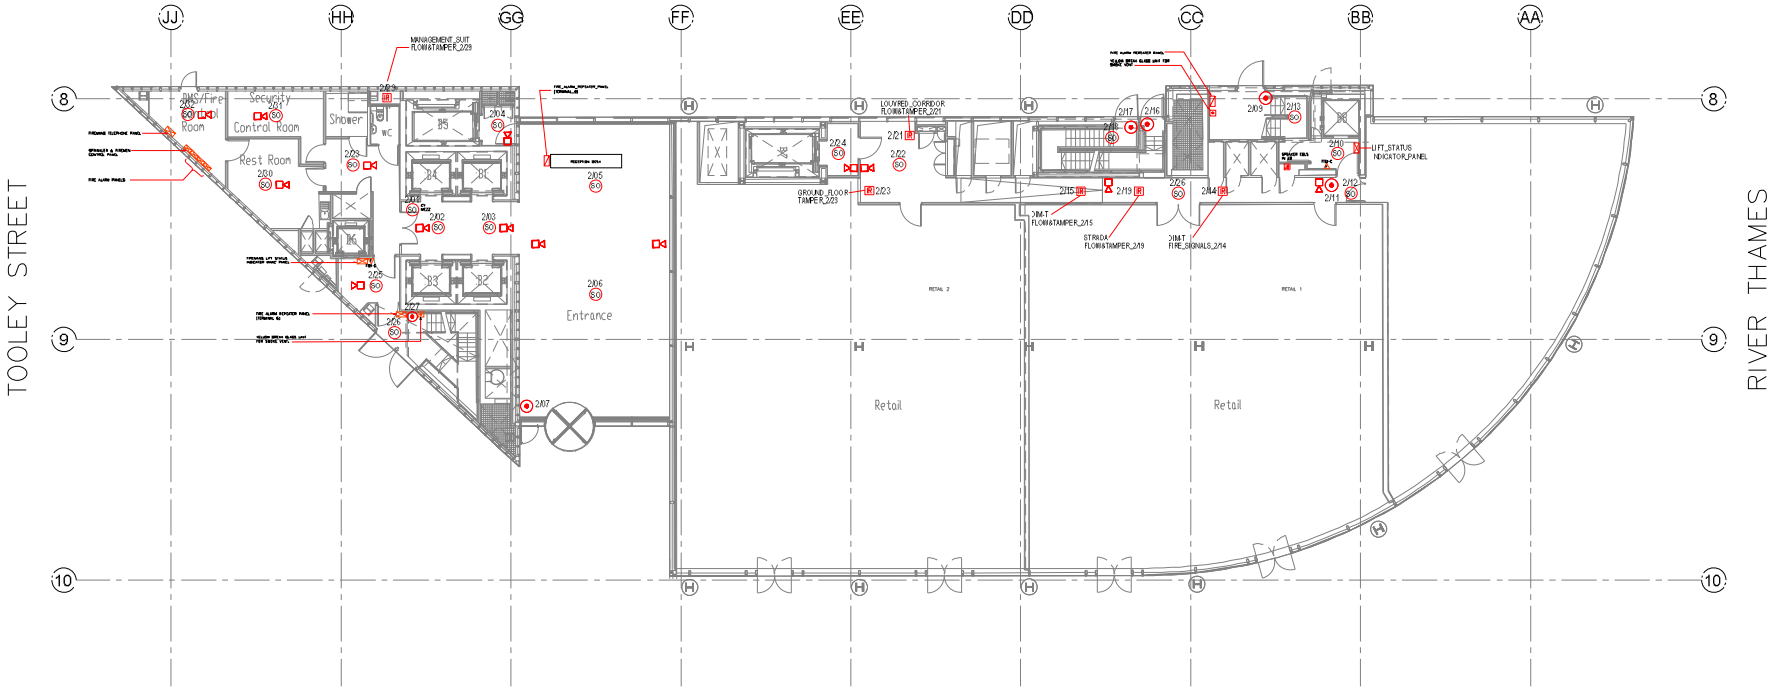

THIS DRAWING IS ISSUED UPON THE UNDERSTANDING THAT THE INFORMATION SHOWN THEREON SHALL NOT BE COPIED OR DISCLOSED TO A THIRD PARTY WITHOUT THE WRITTEN CONSENT OF BTE SYSTEMS LTD

LEGEND:

- SMOKE DETECTOR
- SMOKE DETECTOR IN CEILING VOID
- HEAT DETECTOR
- MANUAL CALL POINT
- VIA SPEAKER
- VIA SPEAKER IN CEILING VOID
- INTERFACE
- FLASHING BEACON
- dB TEST RESULTS

REV	DATE	APP. BY	REVISION DETAILS
A	JULY_18	W.B.	AS_INSTALLED_TO_BE_CHECKED

BTE SYSTEMS
FIRE RISK MANAGEMENT
113 FORDBRIDGE ROAD
ASHFORD
MIDDLESEX TW15 3RZ
TEL: 01784 250977 FAX: 01784 250976

PROJECT: 2 More London Riverside . London

TITLE: Ground Floor
Voice & Fire Alarm System

STATUS: AS INSTALLED

SCALE: 1:100@AO DATE: 26.02.18

DRAWN: LHR APPROVED BY W.B.

DWG NO: BTES-2MPL-414-FA-09

Ground Floor . Voice & Fire Alarm Layout