A1

THIS DRAWING IS ISSUED UPON THE UNDERSTANDING THAT THE INFORMATION SHOWN THEREON SHALL NOT BE COPIED OR DISCLOSED TO A THIRD PARTY WITHOUT THE WRITTEN CONSENT OF BTE SYSTEMS LTD

LEGEND:

- SMOKE DETECTOR
- HEAT DETECTOR
- INTERFACE MODULE
- SOUNDER
- BREAK GLASS UNIT
- POWER SUPPLY UNIT

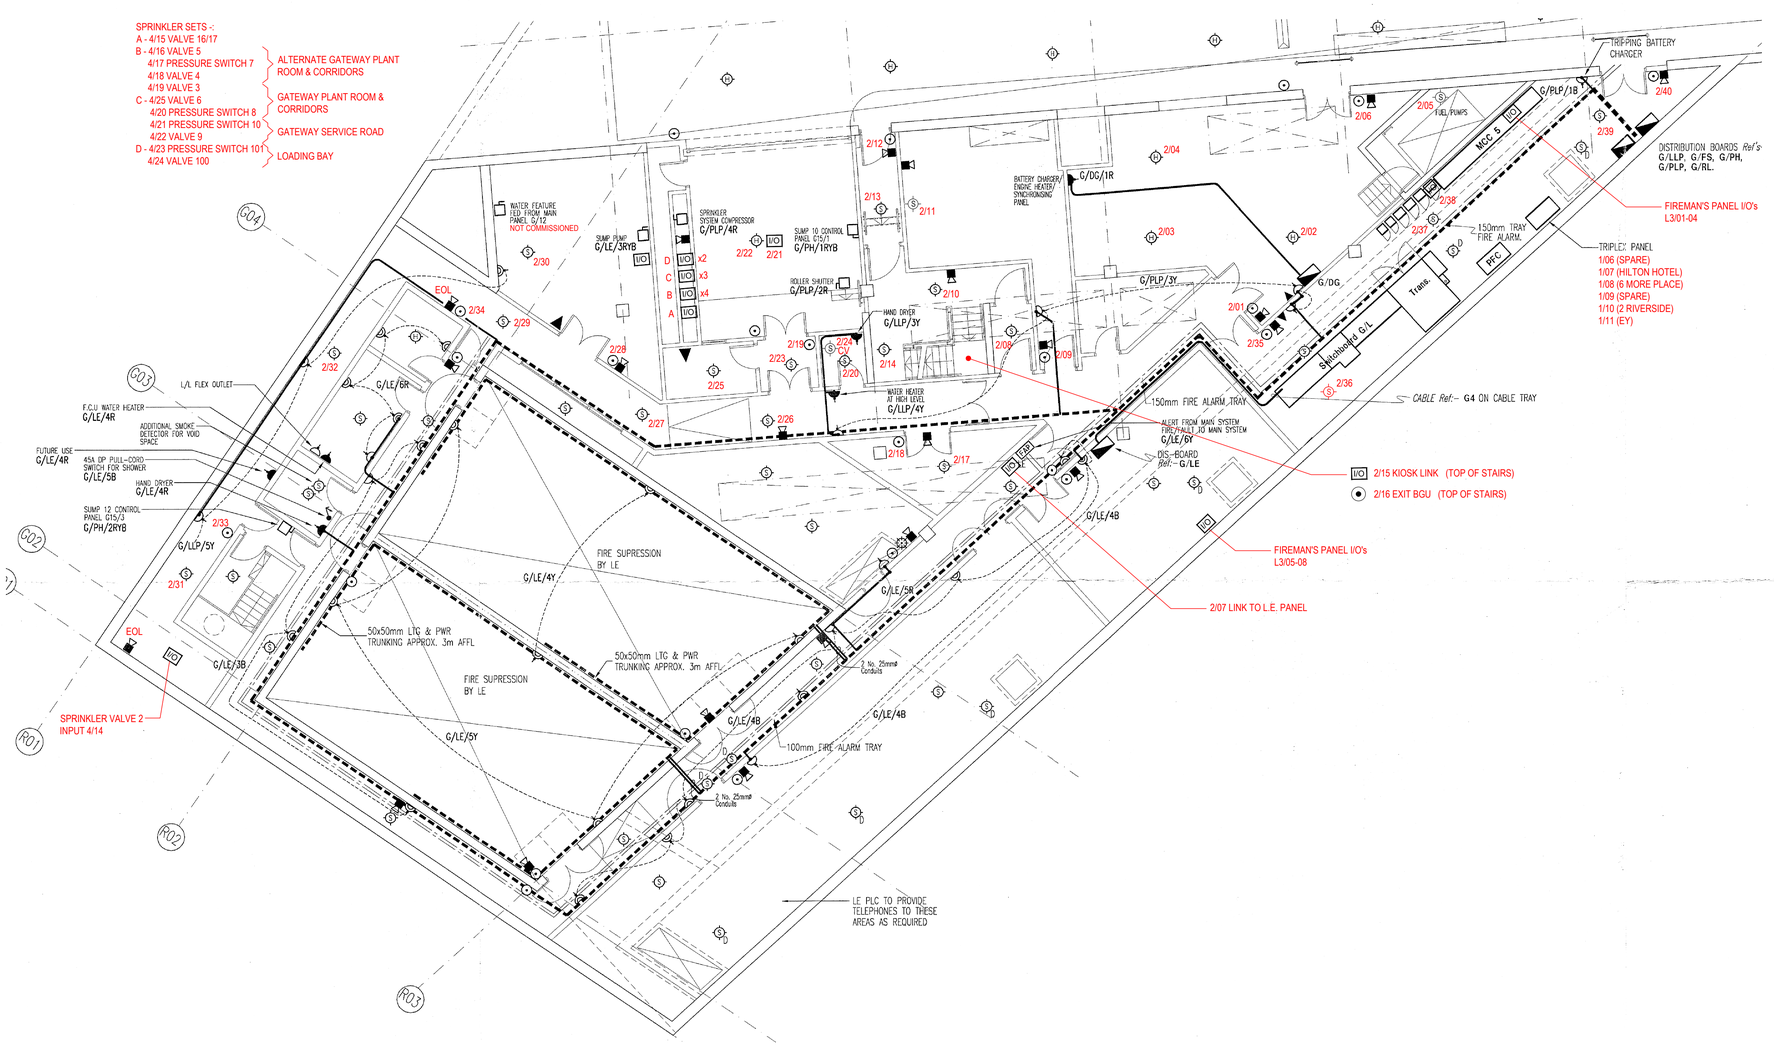

GATEWAY PLANT ROOM LAYOUT

REV	DATE	APP. BY	REVISION DETAILS
A	JAN17	W.B.	AS_INSTALLED

BTE SYSTEMS

FIRE RISK MANAGEMENT

113 FORDBRIDGE ROAD
ASHFORD
MIDDLESEX TW15 3RZ
TEL: 01784 250977 FAX: 01784 250976

PROJECT: More Estates . London Bridge

TITLE: Gateway Plant Rm Fire Alarm System

STATUS: AS INSTALLED

SCALE: 1:100@A1 DATE: 20.12.16

DRAWN: LFB APPROVED BY W.B.

DWG NO: BTES-8429-FA-GPR-01

A1

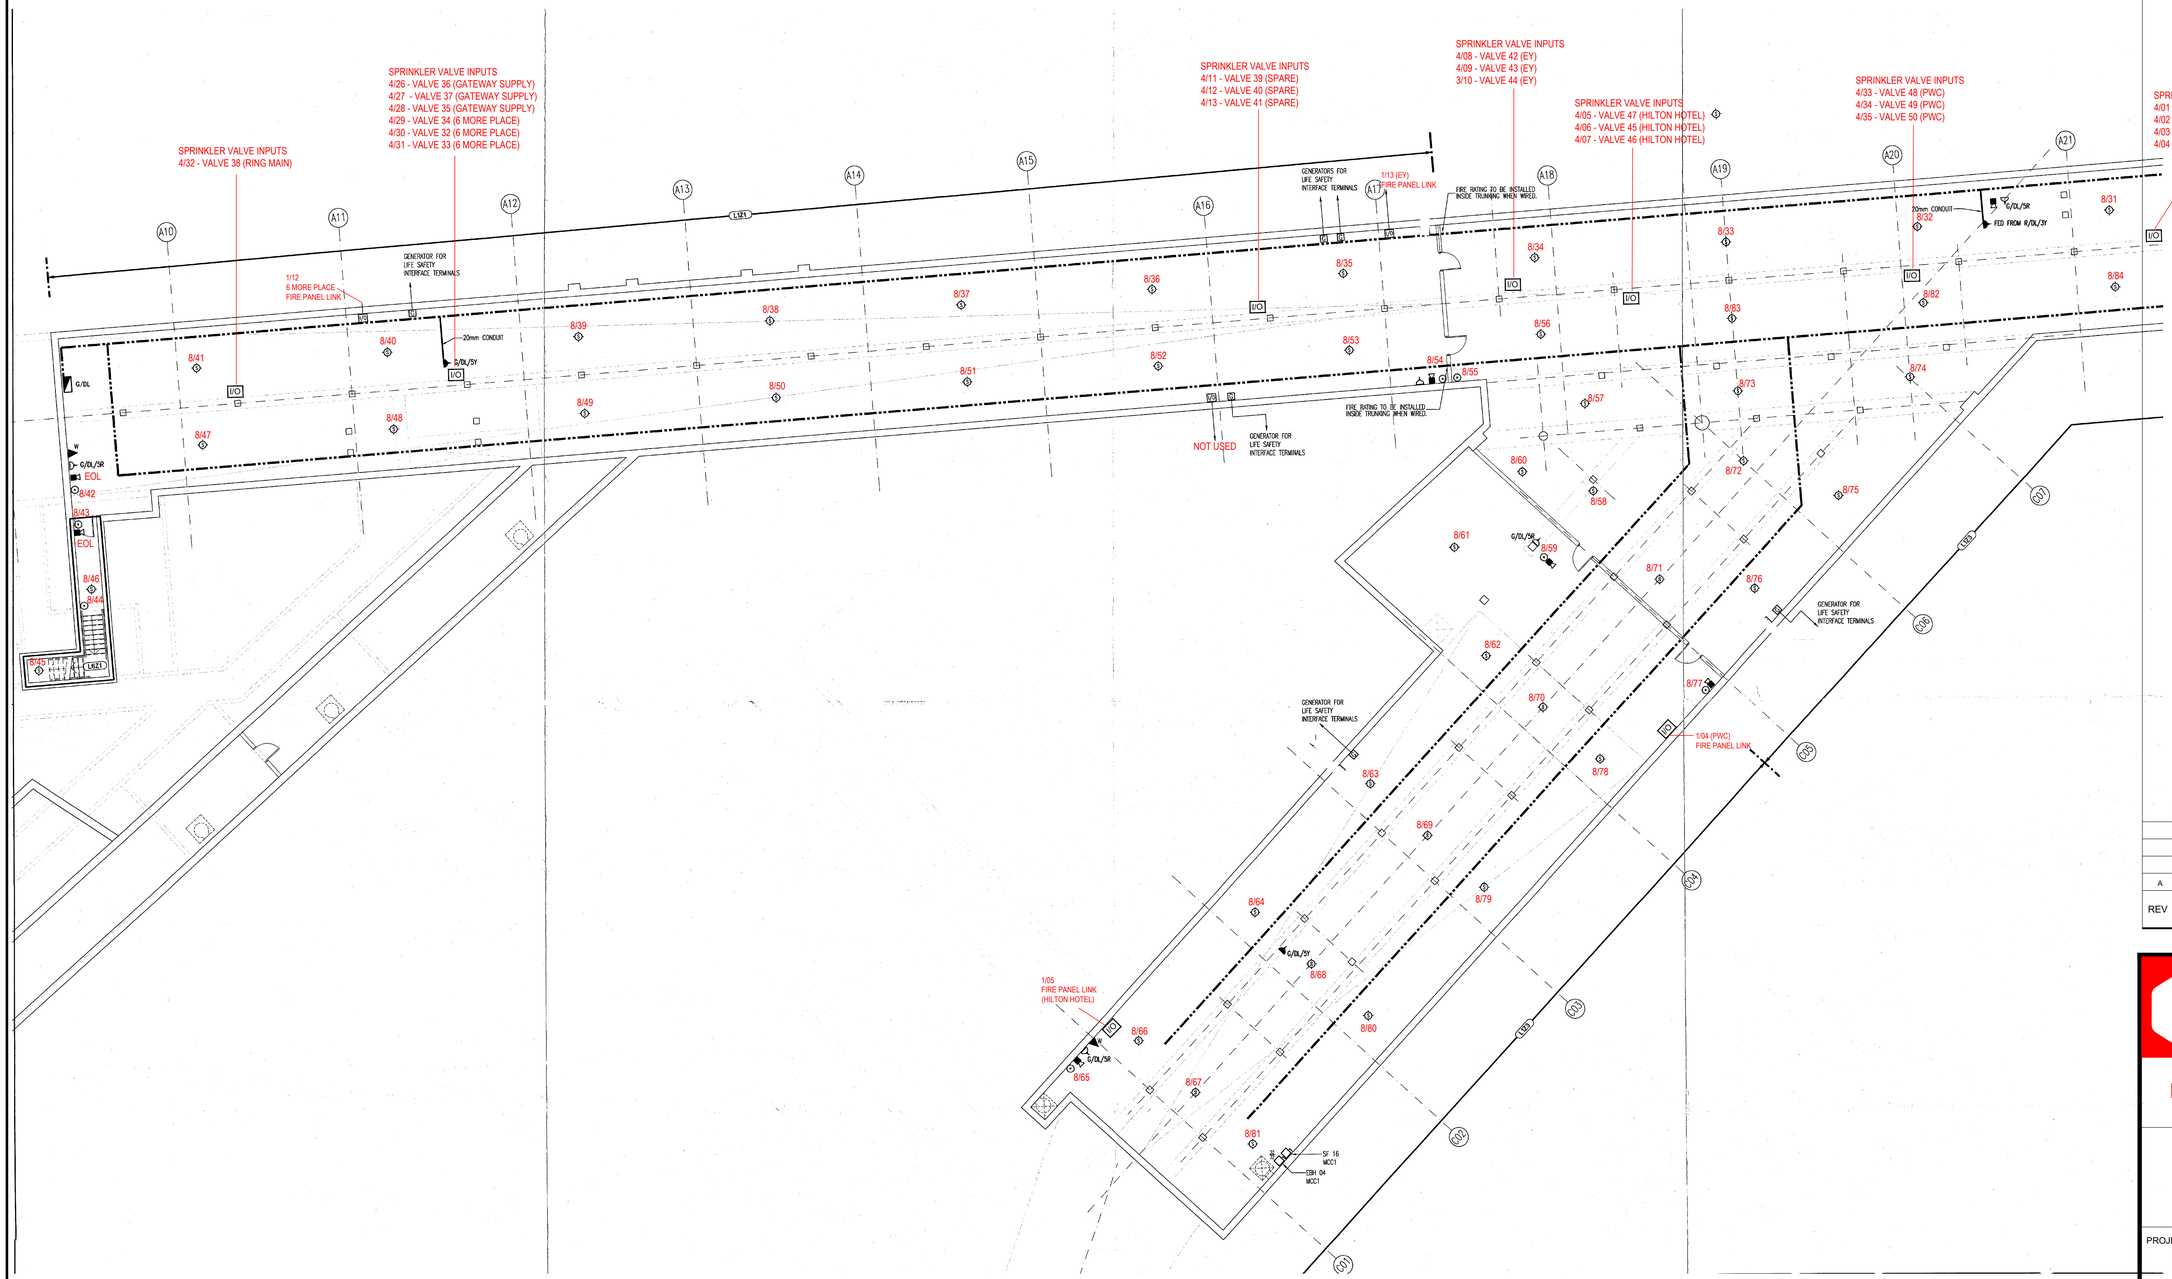

THIS DRAWING IS ISSUED UPON THE UNDERSTANDING THAT THE INFORMATION SHOWN THEREON SHALL NOT BE COPIED OR DISCLOSED TO A THIRD PARTY WITHOUT THE WRITTEN CONSENT OF BTE SYSTEMS LTD

LEGEND:

- S — SMOKE DETECTOR
- H — HEAT DETECTOR
- I/O — INTERFACE MODULE
- SOUNDER
- BREAK GLASS UNIT
- POWER SUPPLY UNIT

REV	DATE	APP. BY	REVISION DETAILS
A	JAN17	W.B.	AS_INSTALLED

BTE SYSTEMS

FIRE RISK MANAGEMENT

113 FORDBRIDGE ROAD
ASHFORD
MIDDLESEX TW15 3RZ
TEL: 01784 250977 FAX: 01784 250976

PROJECT: More Estates . London Bridge

TITLE: Services Duct Level - West Fire Alarm System

STATUS: AS INSTALLED

SCALE: 1:100@A1 DATE: 21.12.16

DRAWN: LFB APPROVED BY W.B.

DWG NO: BTES-8429-FA-SDW-02

SERVICE DUCT LEVEL - WEST LAYOUT

A1

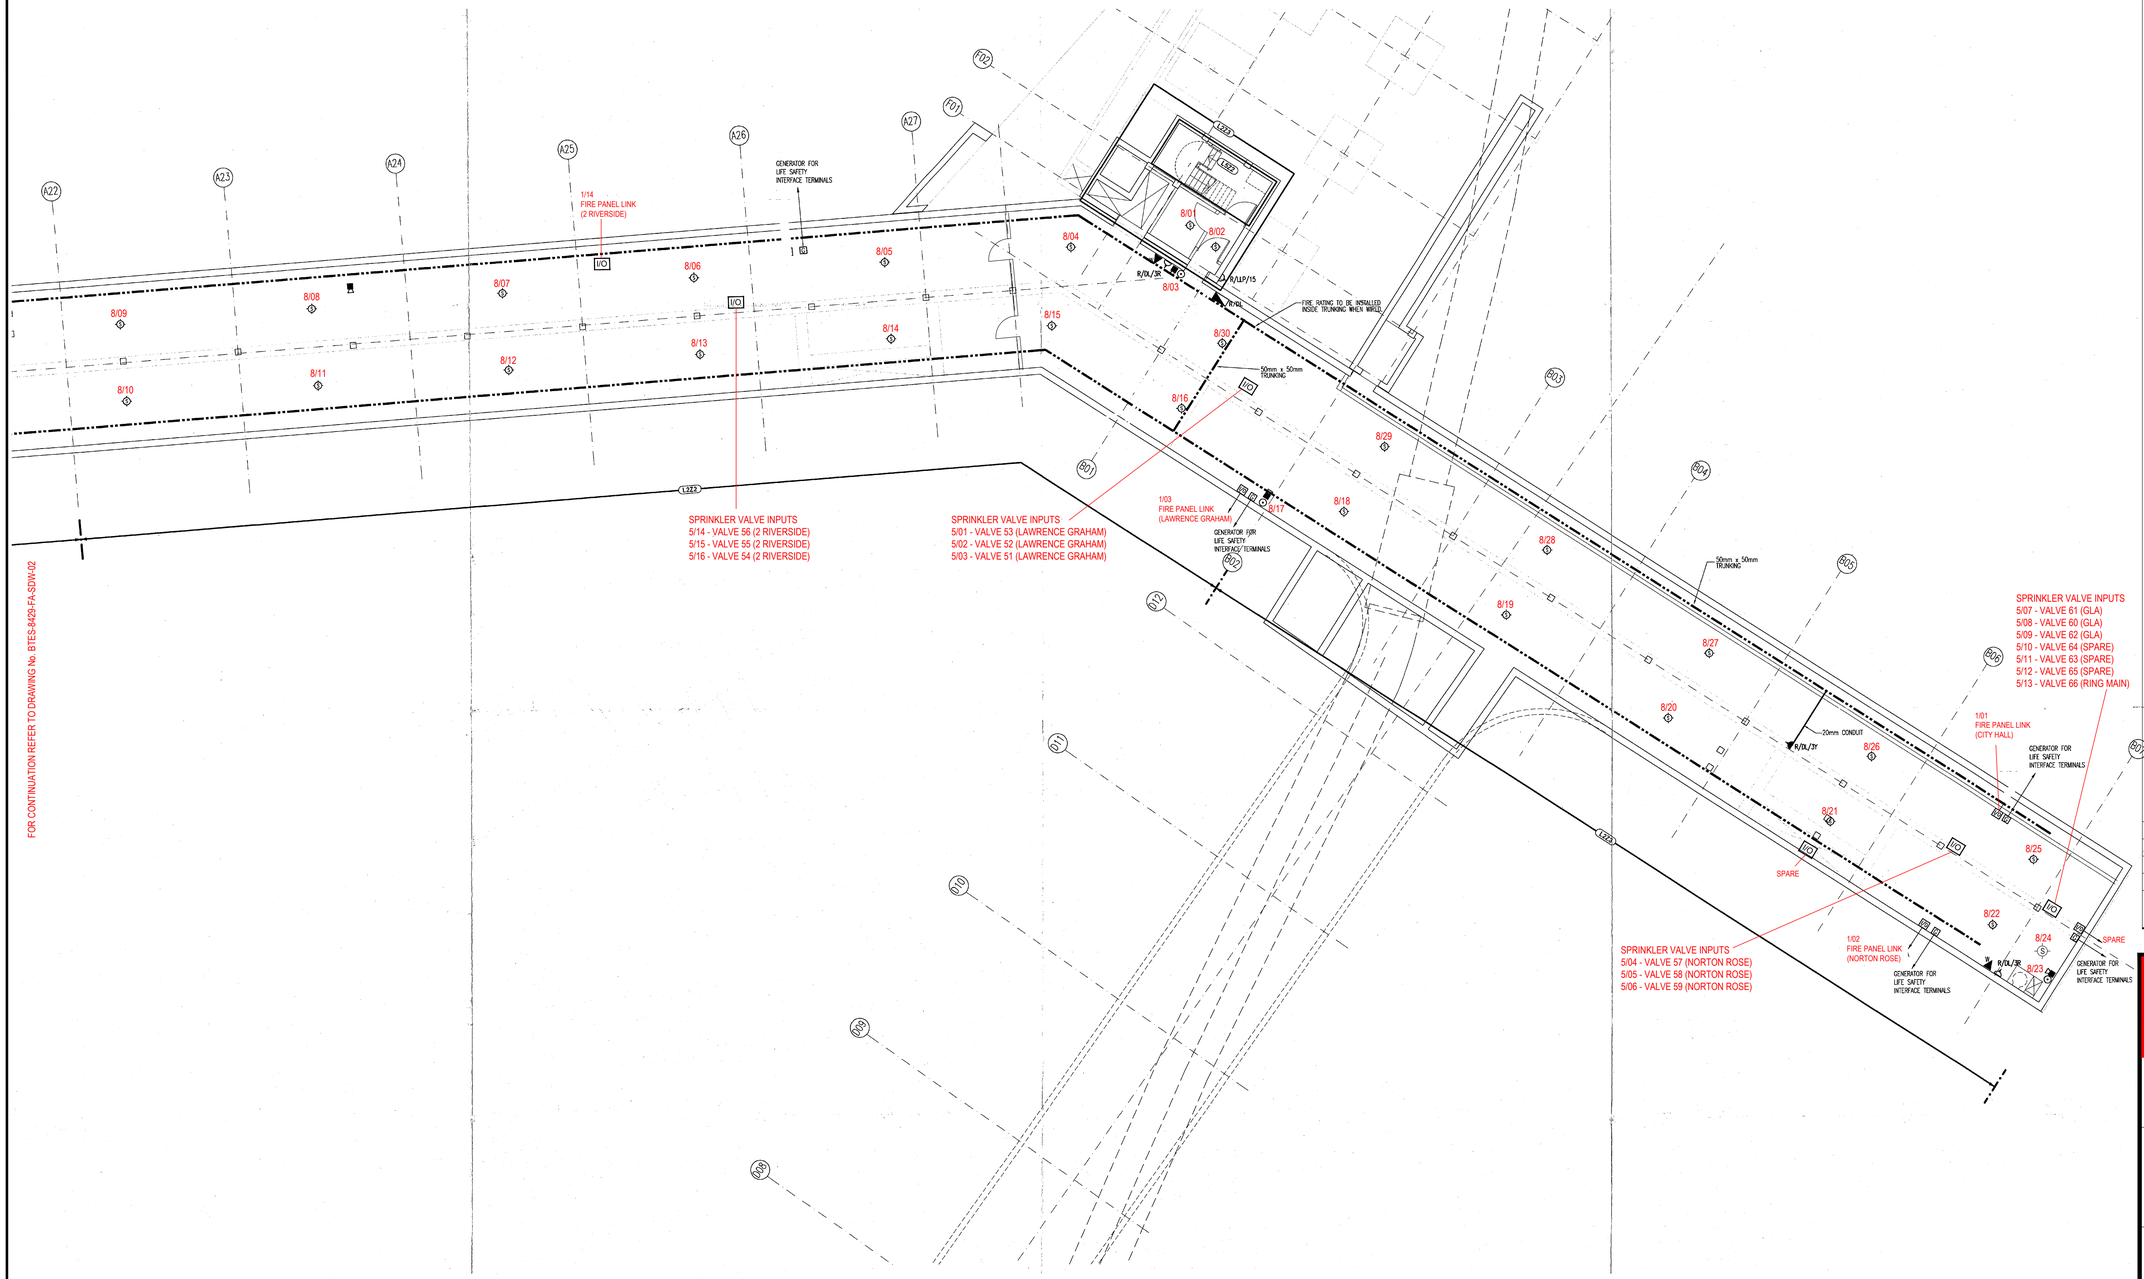

FOR CONTINUATION REFER TO DRAWING No. BTES-8429-FA-SDW-02

THIS DRAWING IS ISSUED UPON THE UNDERSTANDING THAT THE INFORMATION SHOWN THEREON SHALL NOT BE COPIED OR DISCLOSED TO A THIRD PARTY WITHOUT THE WRITTEN CONSENT OF BTE SYSTEMS LTD

LEGEND:

- SMOKE DETECTOR
- HEAT DETECTOR
- INTERFACE MODULE
- SOUNDER
- BREAK GLASS UNIT
- POWER SUPPLY UNIT

REV	DATE	APP. BY	REVISION DETAILS
A	JAN17	W.B.	AS_INSTALLED

BTE SYSTEMS

FIRE RISK MANAGEMENT

113 FORDBRIDGE ROAD
ASHFORD
MIDDLESEX TW15 3RZ
TEL: 01784 250977 FAX: 01784 250976

PROJECT:
More Estates . London Bridge

TITLE:
Services Duct Level - East
Fire Alarm System

STATUS:
AS INSTALLED

SCALE: 1:100@A1 DATE: 21.12.16

DRAWN: LFB APPROVED BY W.B.

DWG NO:
BTES-8429-FA-SDE-03

SERVICE DUCT LEVEL - EAST LAYOUT

A1

THIS DRAWING IS ISSUED UPON THE UNDERSTANDING THAT THE INFORMATION SHOWN THEREON SHALL NOT BE COPIED OR DISCLOSED TO A THIRD PARTY WITHOUT THE WRITTEN CONSENT OF BTE SYSTEMS LTD

LEGEND:

- (S) SMOKE DETECTOR
- (H) HEAT DETECTOR
- I/O INTERFACE MODULE
- SOUNDER
- BREAK GLASS UNIT
- POWER SUPPLY UNIT
- (I) ISOLATOR BASE FITTED

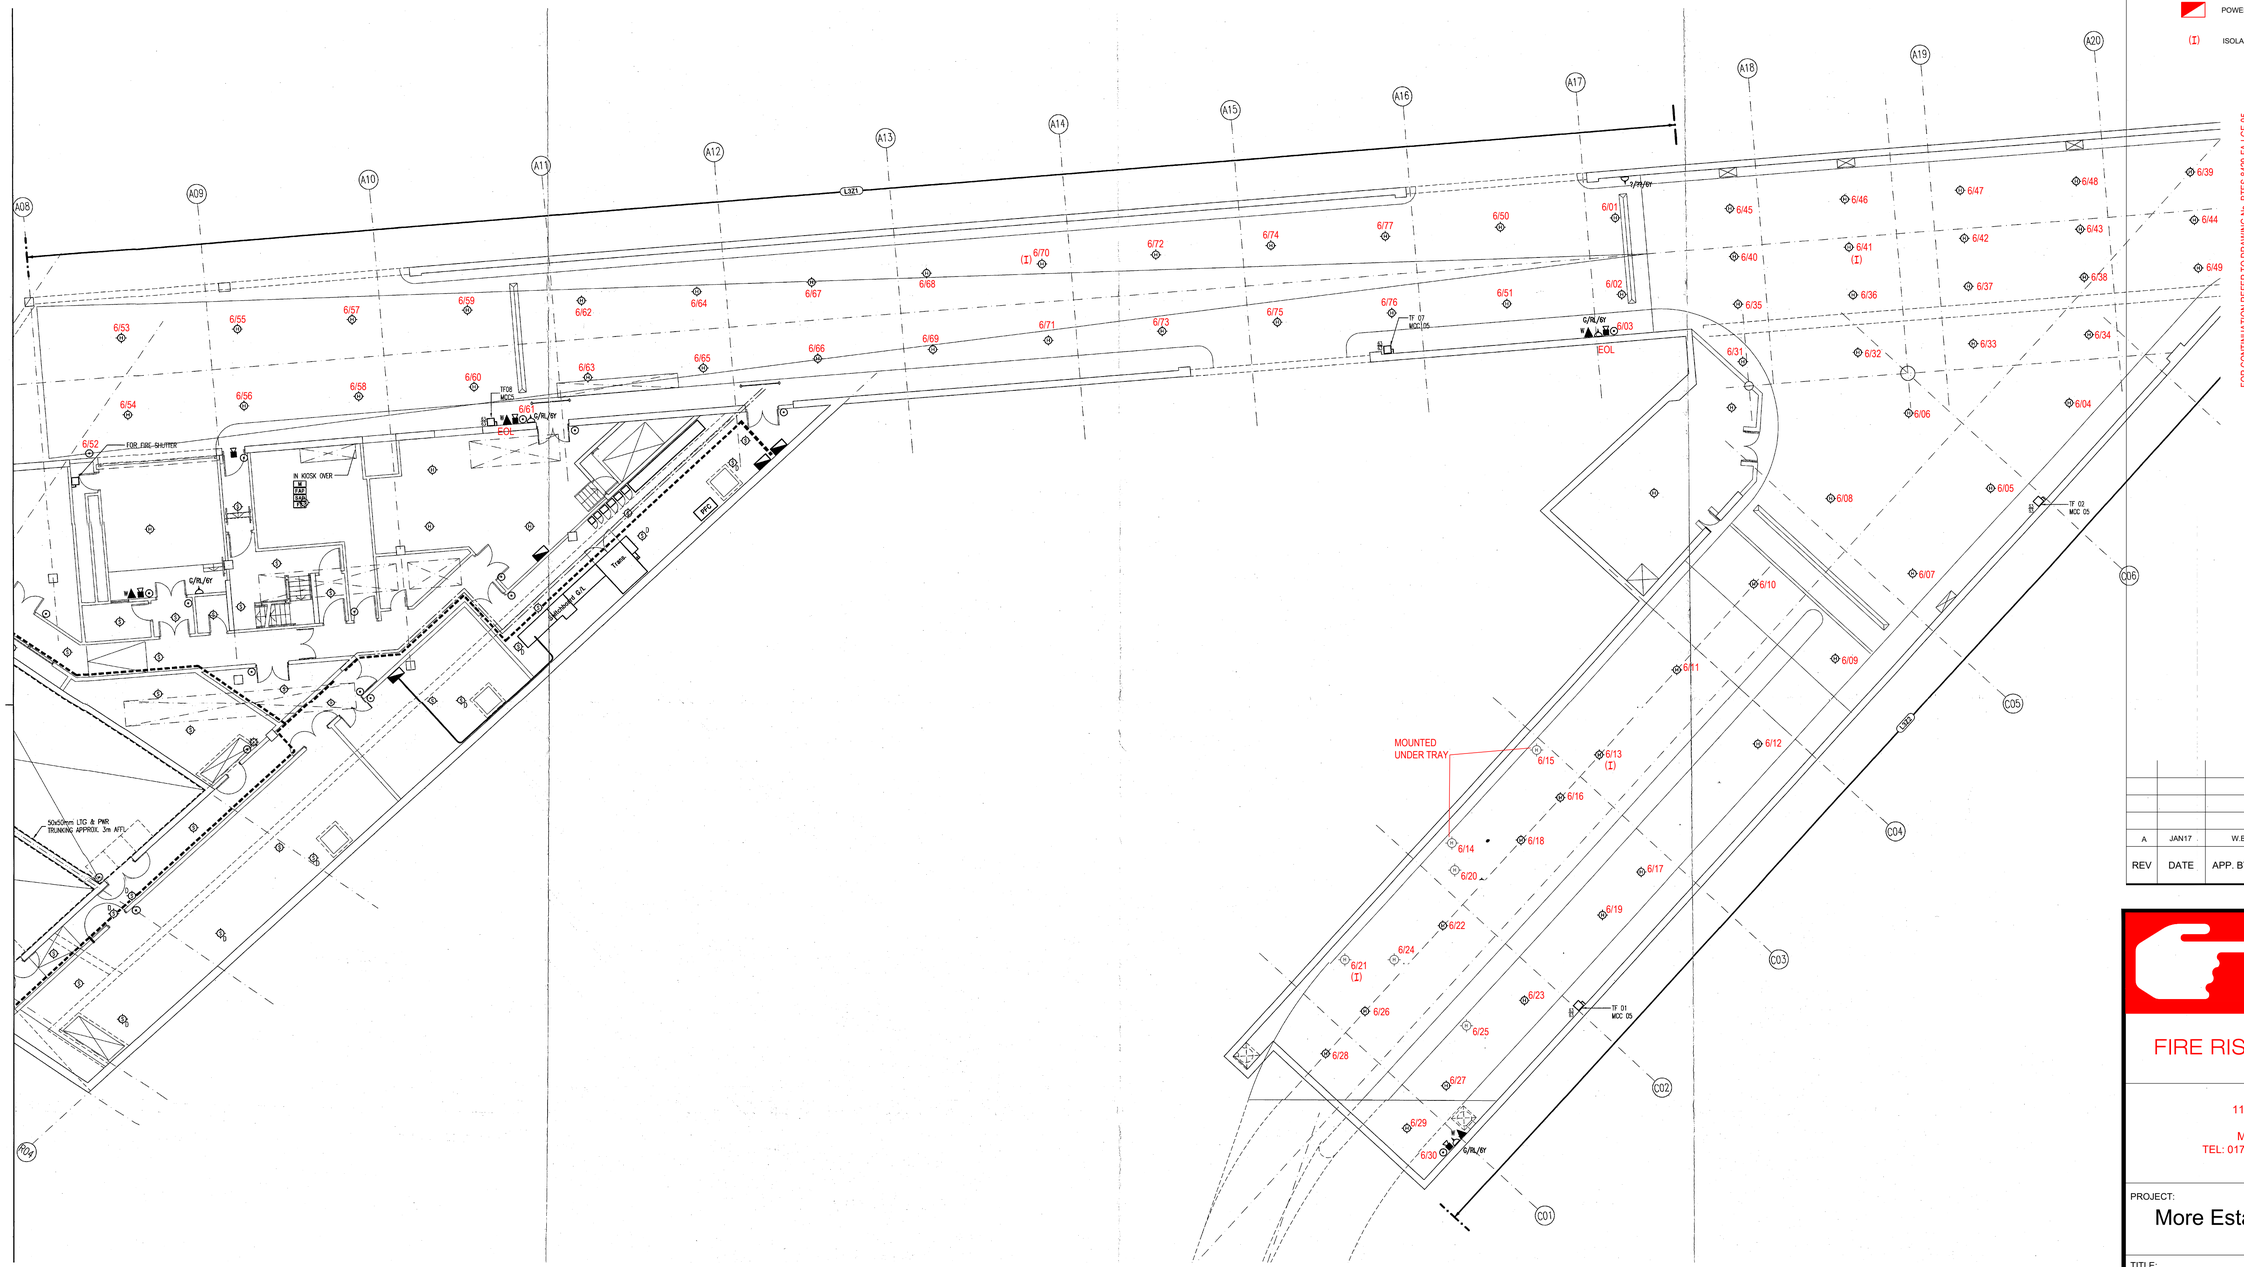

REV	DATE	APP. BY	REVISION DETAILS
A	JAN17	W.B.	AS_INSTALLED

LOWER GROUND LEVEL WEST LAYOUT

BTE SYSTEMS

FIRE RISK MANAGEMENT

113 FORDBRIDGE ROAD
ASHFORD
MIDDLESEX TW15 3RZ
TEL: 01784 250977 FAX: 01784 250976

PROJECT: More Estates . London Bridge

TITLE: Lower Ground Level - West Fire Alarm System

STATUS: AS INSTALLED

SCALE: 1:100@A1 DATE: 21.12.16

DRAWN: LFB APPROVED BY W.B.

DWG NO: BTES-8429-FA-LGW-04

A1

THIS DRAWING IS ISSUED UPON THE UNDERSTANDING THAT THE INFORMATION SHOWN THEREON SHALL NOT BE COPIED OR DISCLOSED TO A THIRD PARTY WITHOUT THE WRITTEN CONSENT OF BTE SYSTEMS LTD

LEGEND:

- S — SMOKE DETECTOR
- H — HEAT DETECTOR
- I/O — INTERFACE MODULE
- SOUNDER
- BREAK GLASS UNIT
- POWER SUPPLY UNIT
- (I) — ISOLATOR BASE FITTED

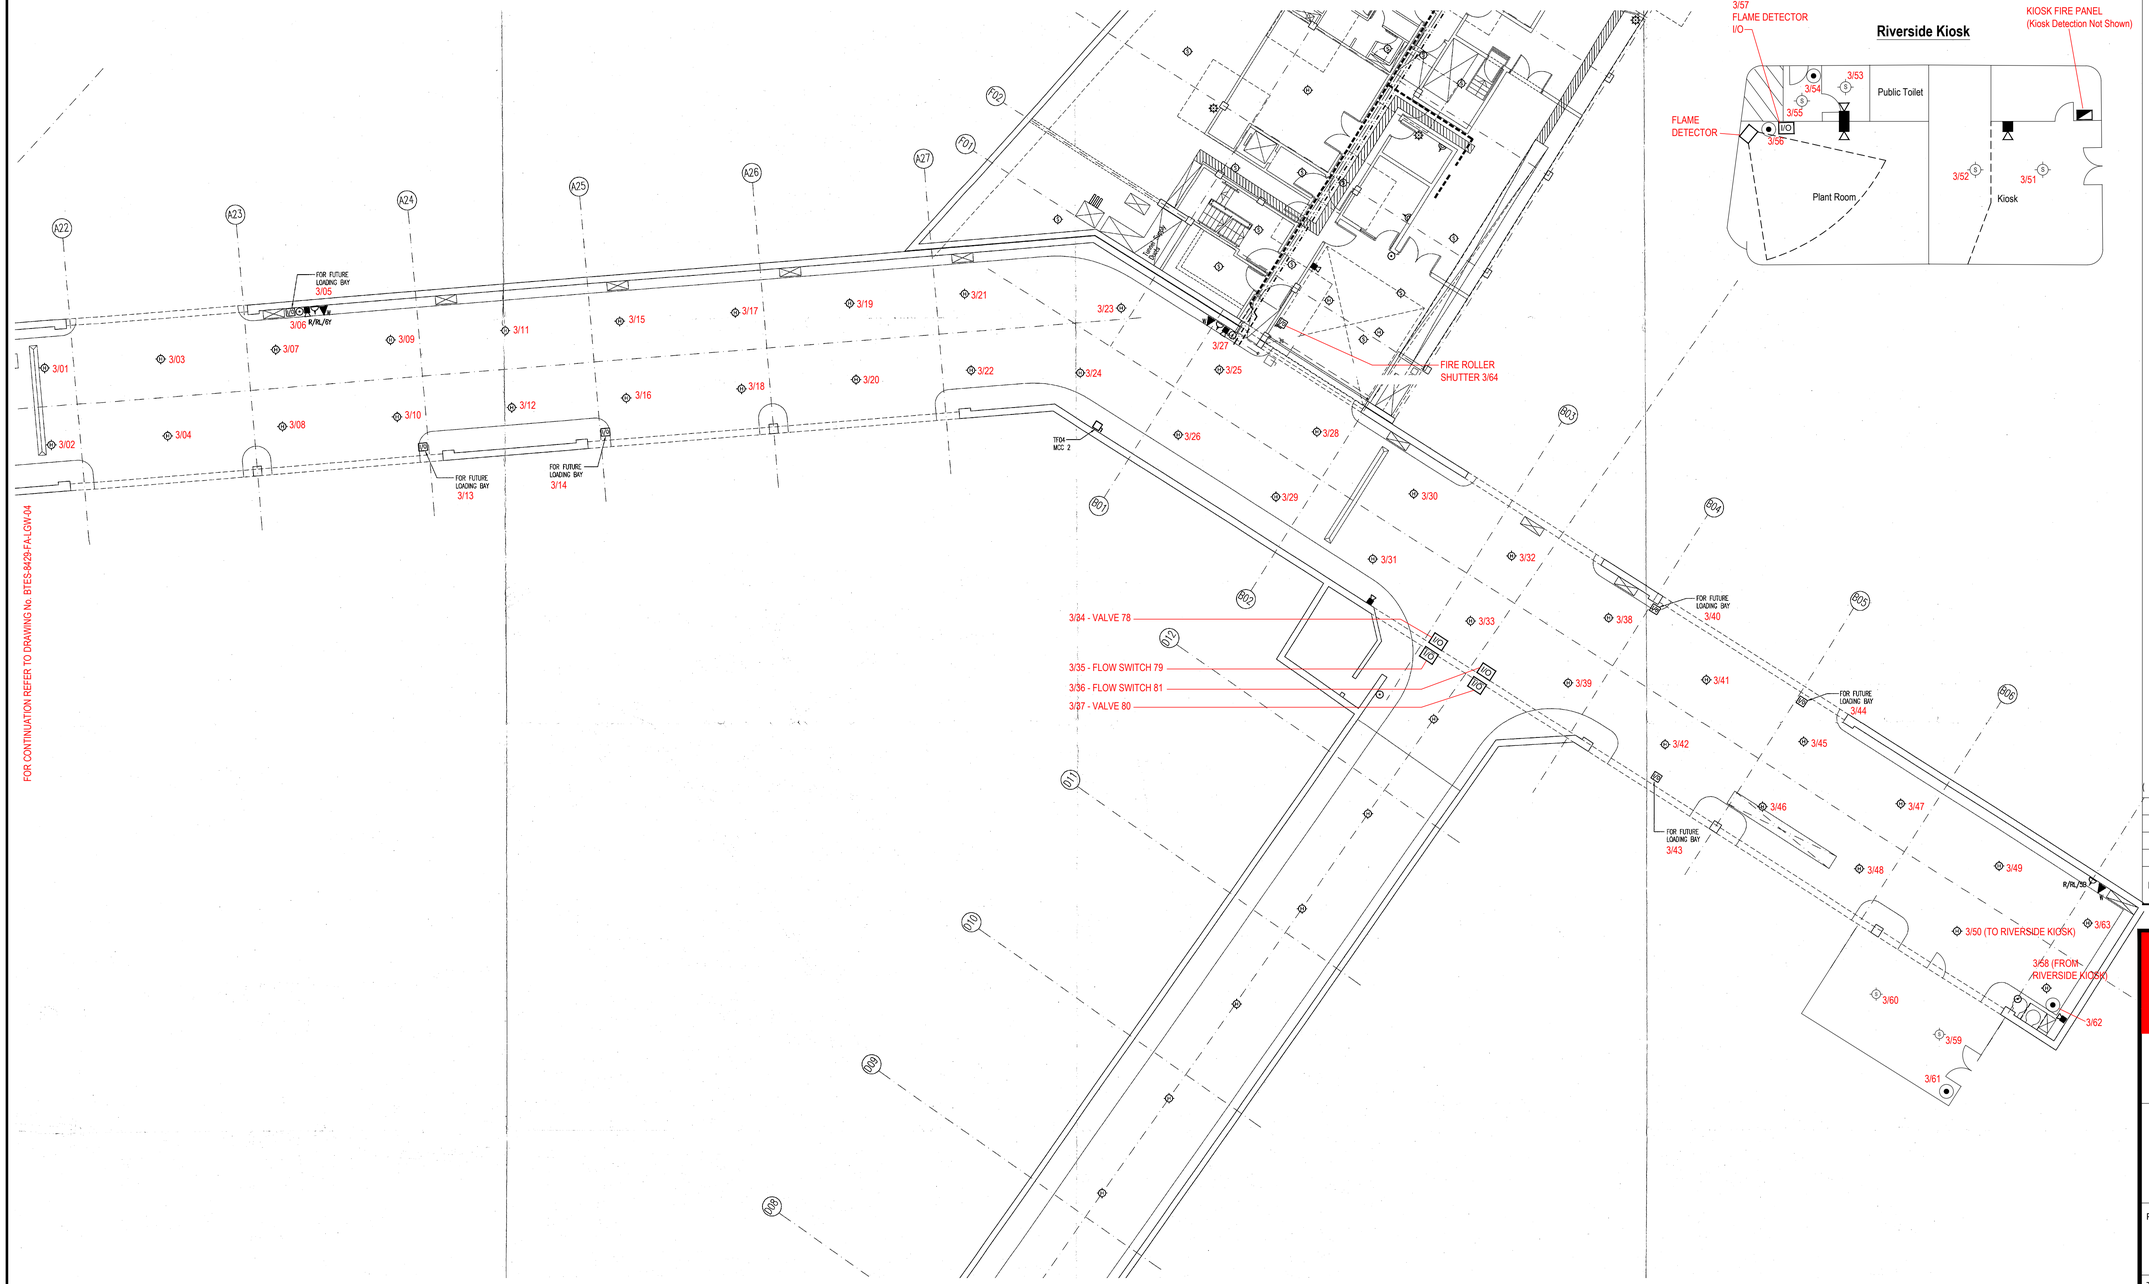

REV	DATE	APP. BY	REVISION DETAILS
A	JAN17	W.B.	AS_INSTALLED

BTE SYSTEMS

FIRE RISK MANAGEMENT

113 FORDBRIDGE ROAD
ASHFORD
MIDDLESEX TW15 3RZ
TEL: 01784 250977 FAX: 01784 250976

PROJECT: More Estates . London Bridge

TITLE: Lower Ground Level - East Fire Alarm System

STATUS: AS INSTALLED

SCALE:	1:100@A1	DATE:	21.12.16
DRAWN:	LFB	APPROVED BY	W.B.

DWG NO: BTES-8429-FA-LGE-05

LOWER GROUND LEVEL EAST LAYOUT

A1

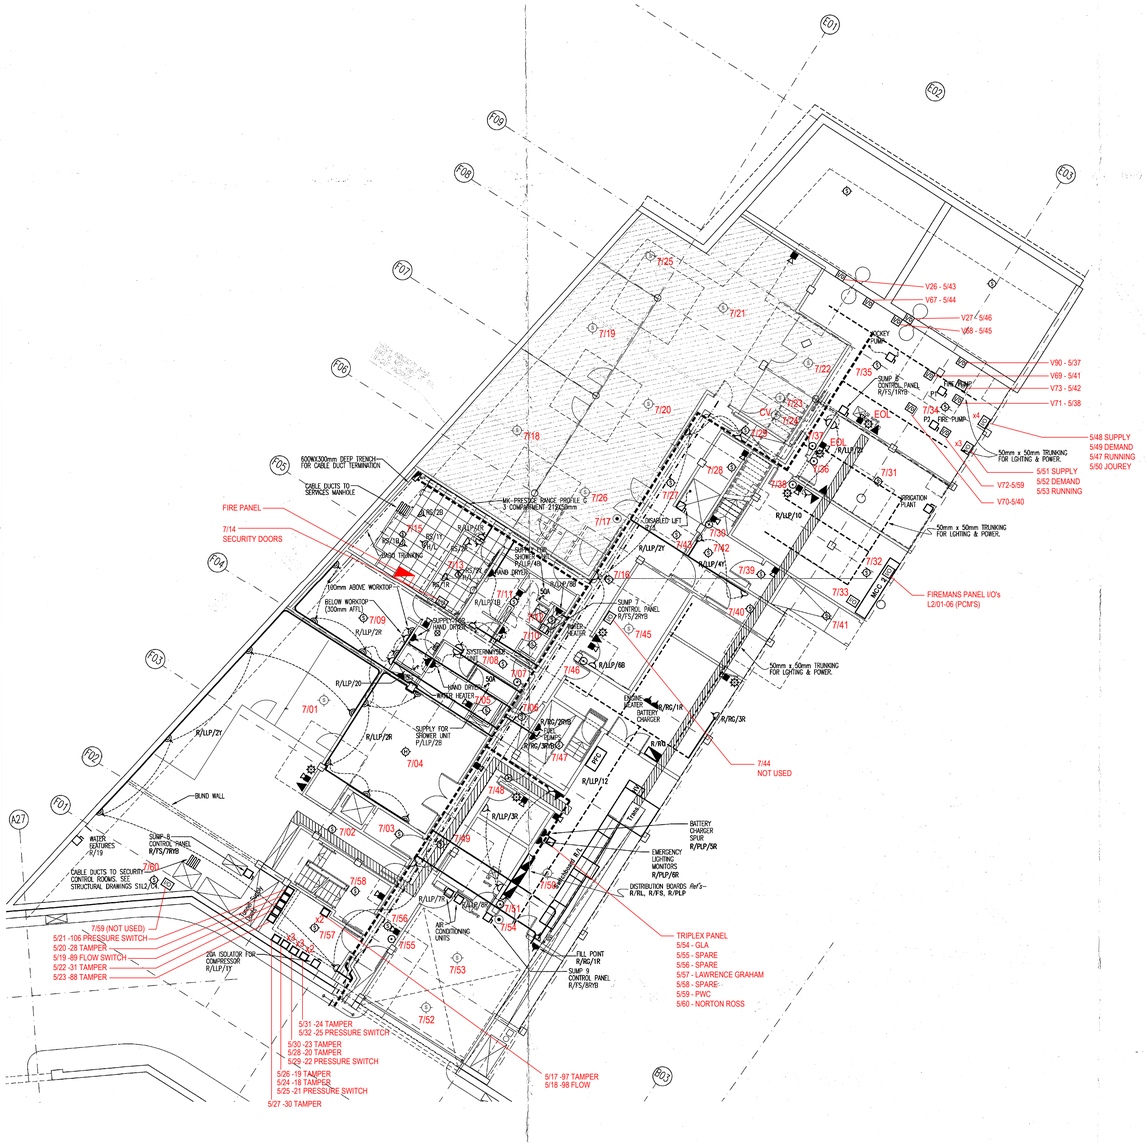
E01
E02
E03
F01
F02
F03
F04
F05
F06
F07
F08
F09
A27
B01
7/01
7/02
7/03
7/04
7/05
7/06
7/07
7/08
7/09
7/10
7/11
7/12
7/13
7/14
7/15
7/16
7/17
7/18
7/19
7/20
7/21
7/22
7/23
7/24
7/25
7/26
7/27
7/28
7/29
7/30
7/31
7/32
7/33
7/34
7/35
7/36
7/37
7/38
7/39
7/40
7/41
7/42
7/43
7/44
7/45
7/46
7/47
7/48
7/49
7/50
7/51
7/52
7/53
7/54
7/55
7/56
7/57
7/58
7/59
7/60
7/61
R/LLP/1R
R/LLP/2R
R/LLP/2T
R/LLP/7T
R/LLP/8B
R/LLP/10
R/LLP/12
R/LLP/3R
R/LLP/5R
R/LLP/7R
R/LLP/8R
R/LLP/9R
R/RG/1R
R/RG/2R
R/RG/3R
