


NOTES:

All dimensions to be checked on site.
Do not scale from this drawing.
Subject to local authority approval.


Drawing for visual purpose only.
For specification refer to scope of works.

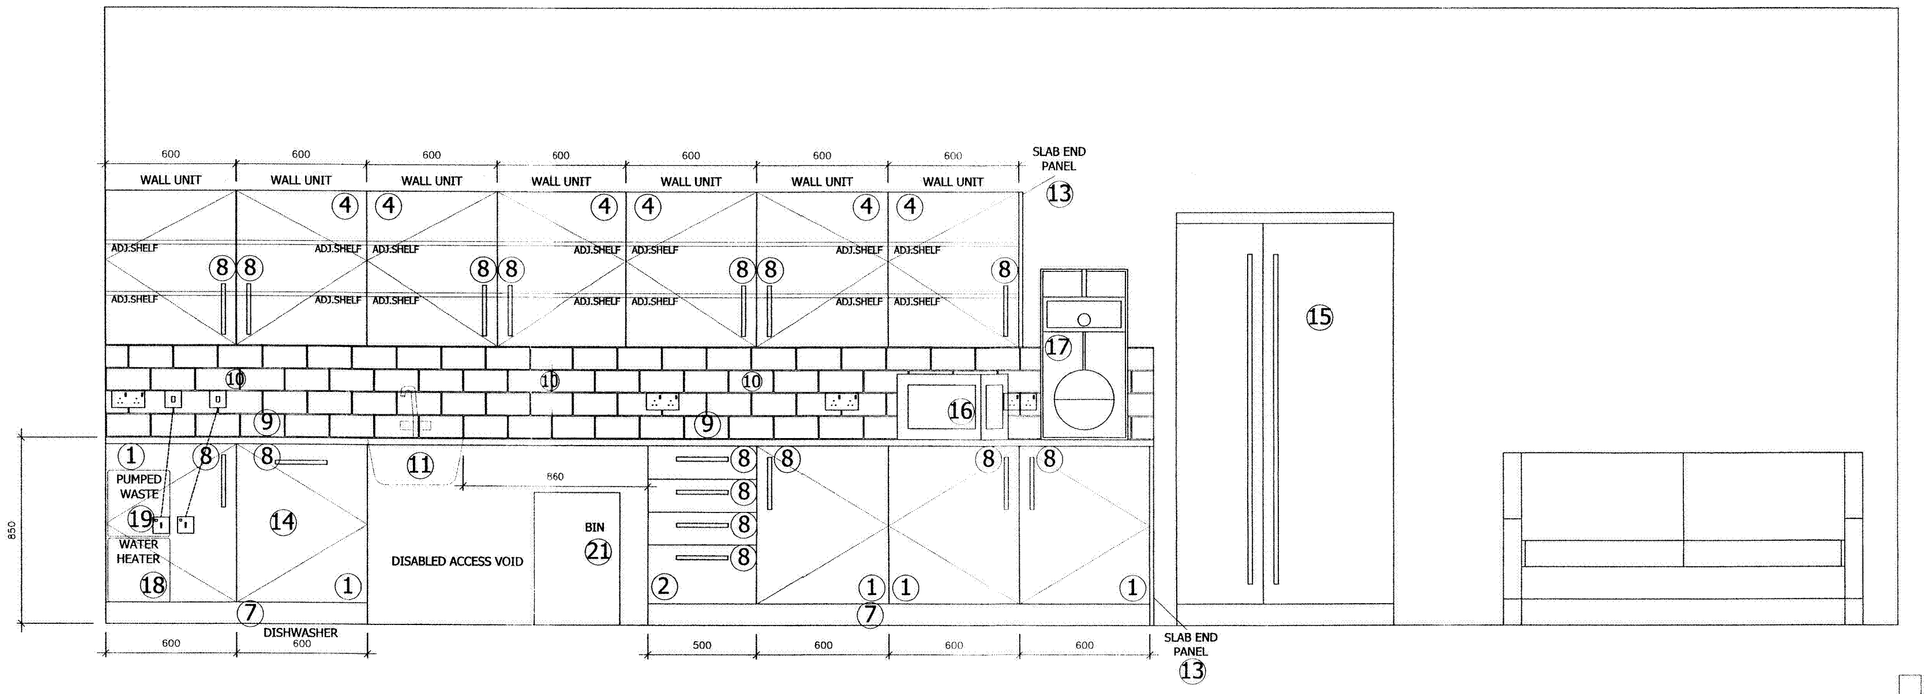


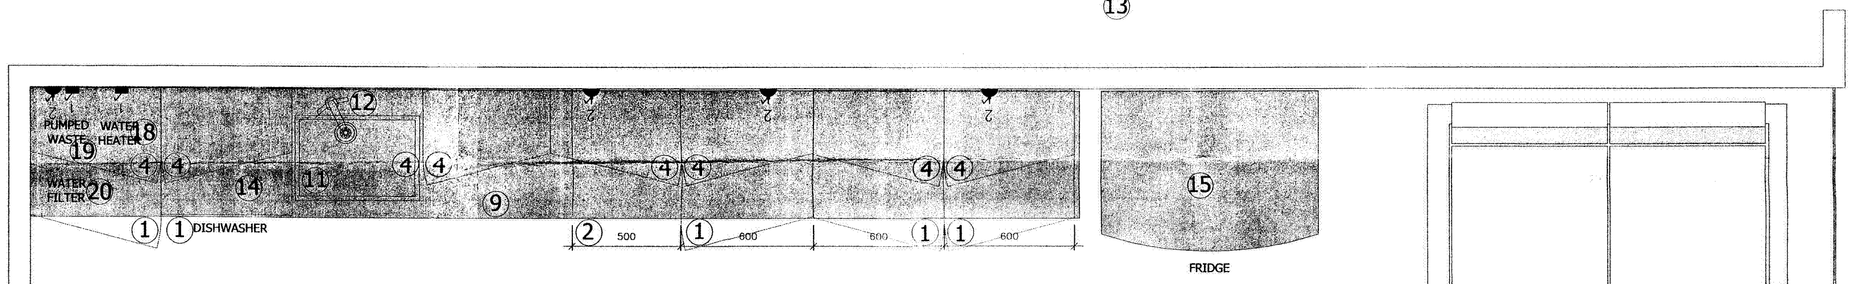

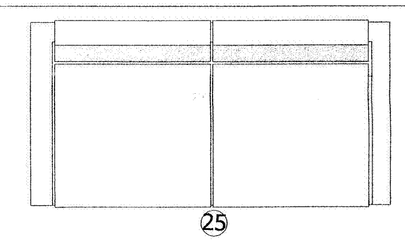

TEAPOINT/ BREAKOUT

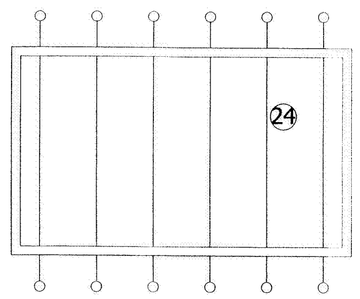

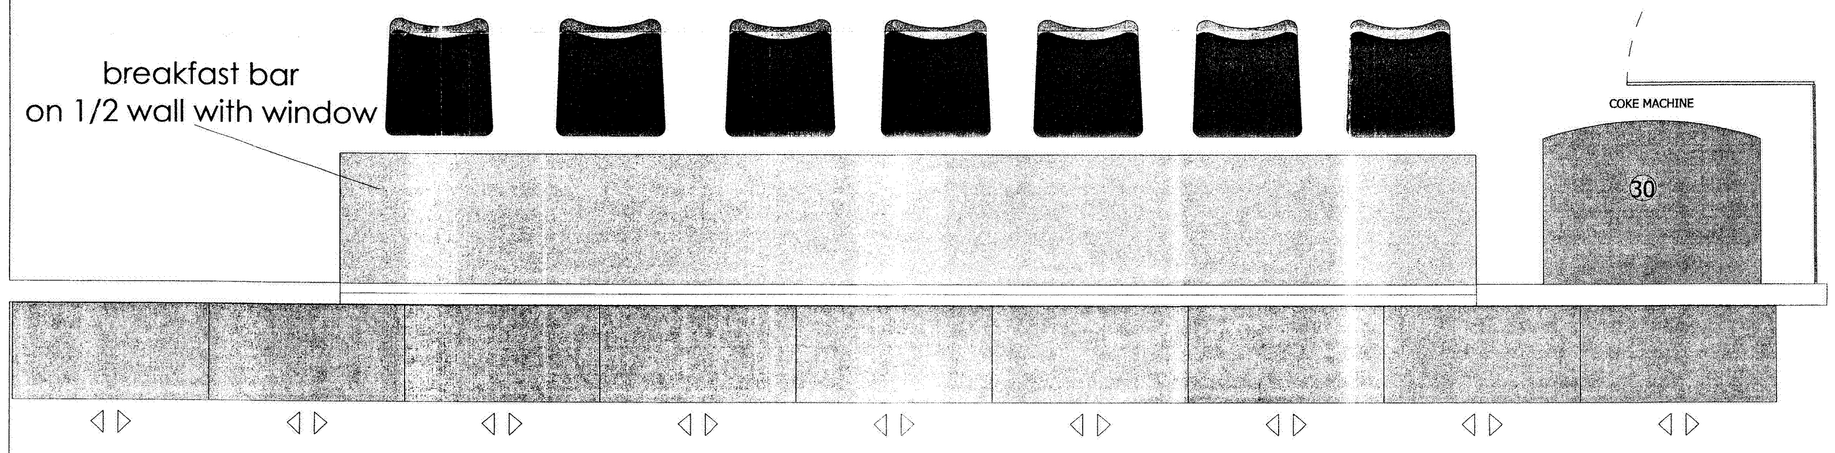

TEAPOINT 1: OPEN PLAN - LEGEND

2	NEW DOUBLE SWITCHED SOCKET OUTLET - WHITE FINISH
1	NEW SINGLE SWITCHED SOCKET OUTLET - WHITE FINISH
1	NEW SINGLE SOCKET WITH SWITCHED SPUR - WHITE FINISH
X/Y	NEW FLOOR SERVICE BOX X - NO OF POWER OUTLETS Y - NO OF DATA OUTLETS
	UNIT SPECIFICATION Magnet Trade - Aspen or Howdens Glendevon White. N.B: Units to be installed on 90mm legs.
1	Wide Single Floor Unit 600w x 822h x 500d
2	4 Drawer Floor Unit 500w x 822h x 500d
4	Wide Single Tall Wall Unit 600w x 720h x 300d
5	'ZIP' BOILER
7	Plinth: To match unit doors, scribed to suit gap under units once installed.
8	Handles: Magnet 237mm Stainless Steel Bar.
9	Worktop: 30mm Thick, Finish - METALLIN PP 4836 CR
10	Splashback: JOHNSON & JOHNSON, White, SIZE: 200 x 100 Brick bonded tile
11	Sink Astra cast onya 570x 430 mm, Single bowl
12	Tap: Magnet - Neptune.
13	Slab End panel
14	Integrated Dishwasher: Spec. from Magnet Trade
15	Large Fridge/Freezer: Spec. from Magnet Trade
16	Microwave: Client own - Sharp
17	Coffee Machine: 'Select Cup' machine supplied by Select Drinks, dims: 790 (h), 400 (w), 519 (d), .
18	Water Heater
19	Pumped Waste
20	Bench Top Filtered Water Unit - Clients Own, Details t.b.c.
21	Bin
24	Table Football
25	Sofa's
27	Floor Covering: Amtico - Pure plain Mist Stud - PN 311
29	Chair
30	Coke Vending Machine - Clients Own.
	Notes: All walls to be painted

Origin:	☐ CAD	☐ IMAGE	☐ SURVEY	
Cad Ref:	05.0076_HGCAPITAL TP			
Status:	☐ For information	For tender	☐ For construction	☒ As built drawing

CLIENT:
HG CAPITAL

ADDRESS:
2 MORE LONDON
RIVERSIDE
LONDON
SE1 2DB

TITLE:
AS BUILT TEA-POINT

bluu solutions limited
Princess House
50-60 Eastcastle Street
London W1W 8EA
t: +44 (0)20 7079 3400
f: +44 (0)20 7323 1723

DESIGN BY	-	MK
DATE	-	07_09_06
SCALE	-	1:20@A1
CAD BY	-	CP
SIGN OFF	-	

Dwg No: 05.0076 - 1 - TP1 AS

Copyright bluu

NOTES:

All dimensions to be checked on site.
Do not scale from this drawing.
Subject to local authority approval.

Drawing for visual purpose only.
For specification refer to scope of works.

SKY / TV SYSTEMS ALLOWANCE:

ALL DISTRIBUTION EQUIPMENT TO BE INSTALLED / COMMISSIONED BY THE CLIENT
ALL CABLE TERMINATION TO BE BY CLIENTS SPECIALIST CONTRACTOR

1 X CT100 COAXIAL CABLE FROM THE ROOF ABOVE THE ELECTRICAL RISER TO THE COMMS ROOM FOR SKY
1 X CT100 COAXIAL CABLE FROM THE ROOF ABOVE THE ELECTRICAL RISER TO THE COMMS ROOM FOR FREE VIEW

FINAL POSITIONS TO BE ADVISED BY BSL / CLIENT

COMMS ROOM ALLOWANCE:

ALL ELECTRICAL SUB-CIRCUITS TO BE SUPPLIED VIA THE NEW UPS DISTRIBUTION BOARD FINAL SPEC. TO BE ADVISED BY BSL CLIENT.

6 X 16A 230V DEDICATED SUPPLIES TERMINATING AT COMMANDO OUTLETS TO THE BASE OF THE IT CABINETS
2 X 13A DSSO'S MOUNTED ABOVE THE WORKBENCH AND 1 X 13A DSSO ADJACENT TO UPS
CABLED ON 1 X 32A 230V DEDICATED SUPPLY
1 X 4MM G/Y DEDICATED EARTH TO THE PABX RACK
GENERAL EARTH BONDING TO ALL IT RACKS TO BS 7671

TEA POINT / BREAKOUT AREA ALLOWANCE:

4 X 13A DSSO'S
2 X FRIDGE SUPPLIES
1 X DISHWASHER (2400 WATTS MAX 230V)
1 X MICROWAVE SUPPLY (1000 WATTS MAX 230V)
1 X TOASTER
1 X WATER COOLER
1 X UNDER-SINK WATER HEATER (2400 WATT MAX 230V)
1 X 5a SP+N SUPPLY FOR PUMPED WASTE UNIT
EARTH BONDING TO BS7671
3 x RJ45 OUTLETS

FINAL POSITIONS TO BE ADVISED BY BSL

KITCHEN ALLOWANCE:

5 X 13A DSSO'S
2 X FRIDGE SUPPLIES
1 X DISHWASHER (2400 WATTS MAX 230V)
1 X OVEN (6000 WATTS MAX 230V)
1 X HOB (5000 WATTS MAX 230V)
1 X TOASTER
1 X UNDER-SINK WATER HEATER SUPPLY (2400 WATTS 230V MAX)
1 X 5a SP+N SUPPLY FOR PUMPED WASTE
2 X RJ45 OUTLETS

EARTH BONDING TO BS7671

FINAL POSITIONS TO BE ADVISED BY BSL

MAINS DISTRIBUTION SYSTEM

SEE ETL DRAWING 1368-1-M-REV B

WHITE BOARD:
1 X 13A DSSO
1 X 120MM GROMMET (G)WITH 25 MM CONDUIT TO FLOOR VOID.
FINAL POSITION TO BE ADVISED BY BSL.

1722mm
WHITE BOARD
1336mm
100mm
13a DSSO
G
100mm

MEETING ROOM 7:
1 X 5a SP+N TO CEILING VOID FOR PROJECTOR
1 X 13A DSSO TO CEILING VOID FOR AP
1 X RJ45 TO CEILING VOID FOR AP
1 X TWIN METAL BACK BOX 35MM DEEP ( ) WITH 4 X 20MM FLEXIBLE CONDUITS TO THE CEILING AND FLOOR VOIDS WITH DRAW WIRES AND ENDS LEFT OPEN

SHOWER ROOMS:
2 X 9000 WATT SP+N SUPPLIES FOR SHOWER UNITS (45a MAX)
1 X 5a SP+N SUPPLY FOR PUMPED WASTE UNIT
2 X 1500 WATT SP+N SUPPLIES FOR HAIR DRYERS
1 x SHAVER OUTLET TO MALE SHOWER
SEE DETAILED DRAWING: DT 1 & DT 2 REV B

MAINS DISTRIBUTION SYSTEM

SEE ETL DRAWING 1368-1-M-REV B

EXHIBITION WALL:
1 X 4MM 3 CORE XLPE/SWA/PVC SUPPLY FROM ADJACENT DB
FINAL DETAILS TO BE CONFIRMED

MEETING ROOM 8:
1 X 5a SP+N TO CEILING VOID FOR PROJECTOR
1 X 13A DSSO TO CEILING VOID FOR AP
1 X RJ45 TO CEILING VOID FOR AP
1 X TWIN METAL BACK BOX 35MM DEEP ( ) WITH 4 X 20MM FLEXIBLE CONDUITS TO THE CEILING AND FLOOR VOIDS WITH DRAW WIRES AND ENDS LEFT OPEN
FINAL POSITIONS TO BE ADVISED BY BSL

TOUCHDOWN AREA:
3 X 13a DSSO TO PARTITION WALL FOR TOUCH DOWN BENCH
SEE DETAIL ELEVATION DRAWING DT
FINAL POSITIONS TO BE ADVISED BY BSL

MEETING ROOM 5:
1 X TWIN METAL BACK BOX 35MM DEEP ( ) WITH 4 X 20MM FLEXIBLE CONDUITS TO THE CEILING AND FLOOR VOIDS WITH DRAW WIRES AND ENDS LEFT OPEN
1 X 13A DSSO BEHIND PLASMA WHICH IS LOCATED ABOVE CREDENZA
1 X 120MM GROMMET BEHIND PLASMA WITH 25MM CONDUIT TO FLOOR VOID
FINAL POSITIONS TO BE ADVISED BY BSL

MEETING ROOM 4:
1 X 5a SP+N TO FLOOR VOID FOR PRIVALITE GLASS SYSTEM.
1 X SWITCH TO OPERATE ABOVE TO BE PARTITION MOUNTED
FINAL POSITIONS TO BE ADVISED BY BSL

MEETING ROOM 3:
1 X 5a SP+N TO FLOOR VOID FOR PRIVALITE GLASS SYSTEM.
1 X SWITCH TO OPERATE ABOVE TO BE PARTITION MOUNTED
FINAL POSITIONS TO BE ADVISED BY BSL

INFORMAL MEETING AREA:
1 X 13A DSSO TO PARTITION WALL FOR PLASMA
1 X AUDIO VISUAL (PSF 1/3) CABLE RUN FROM COMMS ROOM TO PLASMA POSITION VIA 120MM GROMMET
1 X 120MM GROMMET WITH 2 X 20MM CONDUITS TO CEILING VOID
SEE DETAIL DRAWING DT6

MEETING ROOM 2:
1 X 5a SP+N TO FLOOR VOID FOR PRIVALITE GLASS SYSTEM.
1 X SWITCH TO OPERATE ABOVE TO BE PARTITION MOUNTED
FINAL POSITIONS TO BE ADVISED BY BSL

MEETING ROOM 1:
1 X 5a SP+N TO CEILING VOID FOR PROJECTOR
1 X 13A DSSO TO CEILING VOID FOR AP
1 X RJ45 TO CEILING VOID FOR AP
1 X TWIN METAL BACK BOX 35MM DEEP ( ) WITH 4 X 20MM FLEXIBLE CONDUITS TO THE CEILING AND FLOOR VOIDS WITH DRAW WIRES AND ENDS LEFT OPEN
FINAL POSITIONS TO BE ADVISED BY BSL

TEA POINT / BREAKOUT AREA SEE DRAWING :-
KITCHEN SEE DRAWING :-
COMMS ROOM SEE DRAWING :-
5amp power provision for 4 lift glass boxes - see drawing EL2
5amp power provision in wall hidden behind lift glass box see drawing EL2
5amp power provision in wall hidden behind lift glass box see drawing EL2
ST.WALL

SMALL POWER LEGEND

X / Y	3 COMP. CAVITY FLOOR BOX X = No OF 13a POWER OUTLETS Y = No OF CATEGORY 6 RJ45 OUTLETS
2	13a TWIN SWITCHED SOCKET OUTLET MOUNTED @ 450MM FFFL
A	13a TWIN SWITCHED SOCKET OUTLET MOUNTED ABOVE WORK TOP HEIGHT TBA ON SITE BY BSL
B	13a TWIN SWITCHED SOCKET OUTLET MOUNTED AT HIGH LEVEL / WITHIN CEILING VOID LOCATION TBA ON SITE BY BSL
	UNDER FLOOR BUS BAR SYSTEM INSTALLED TO RAISED FLOOR VOID IN COMPLIANCE WITH BS7671 SECTION 607
AV	FLEXIBLE CONDUITS TO THE CEILING AND FLOOR VOIDS WITH DRAW WIRES AND ENDS LEFT OPEN
H	13a SSSO FLOOR HIVE BOX FOR GENERAL SMALL POWER USAGE
Y	RJ45 CATEGORY 6 OUTLET WALL MOUNTED @ 450MM FFFL Y = NUMBER OF OUTLETS
AY	RJ45 CATEGORY 6 OUTLET MOUNTED ABOVE WORKTOP HEIGHT TBC ON SITE BY BSL Y = NUMBER OF OUTLETS
BY	RJ45 CATEGORY 6 OUTLET MOUNTED WITHIN CEILING VOID Y = NUMBER OF OUTLETS
TV	CT100 COAXIAL RUN FROM COMMS. ROOM AND LEFT UN-TERMINATED AT EACH END. 1m SPARE CABLE WITHIN MEETING ROOM AND 3m WITHIN COMMS. ROOM. ALL EQUIPMENT AND TERMINATION TO BE BY OTHERS AS REQUIRED.

Cad Ref: 06.0076
Status: ☐ For information ☐ For tender ☐ For construction ☒ As built drawing

CLIENT:
H.G. CAPITAL

ADDRESS:
MORE
LONDON

TITLE:
FIRST FLOOR
AS BUILT POWER LAYOUT

bluu solutions limited
Princess House
50-60 Eastcastle Street
London W1W 8EA
t: +44 (0)20 7079 3400
f: +44 (0)20 7323 1723

DESIGN BY	-	MK
DATE	-	25.08.04
SCALE	-	1:100@A1
CAD BY	-	SHK/CP
SIGN OFF	-	

Dwg No: 06.0076 - 1 - PL AS

Copyright bluu

NOTES:

All dimensions to be checked on site.
Do not scale from this drawing.
Subject to local authority approval.


Drawing for visual purpose only.
For specification refer to scope of works.

OPEN PLAN OFFICE & ANCILLARY SPACES
= 859 sqm - 9200 sqft

MEETING SUITE
= 351 sqm - 3777 sqft

RECEPTION & UTILITIES
= 130 sqm - 1399 sqft

PICTURE RAIL TRIM

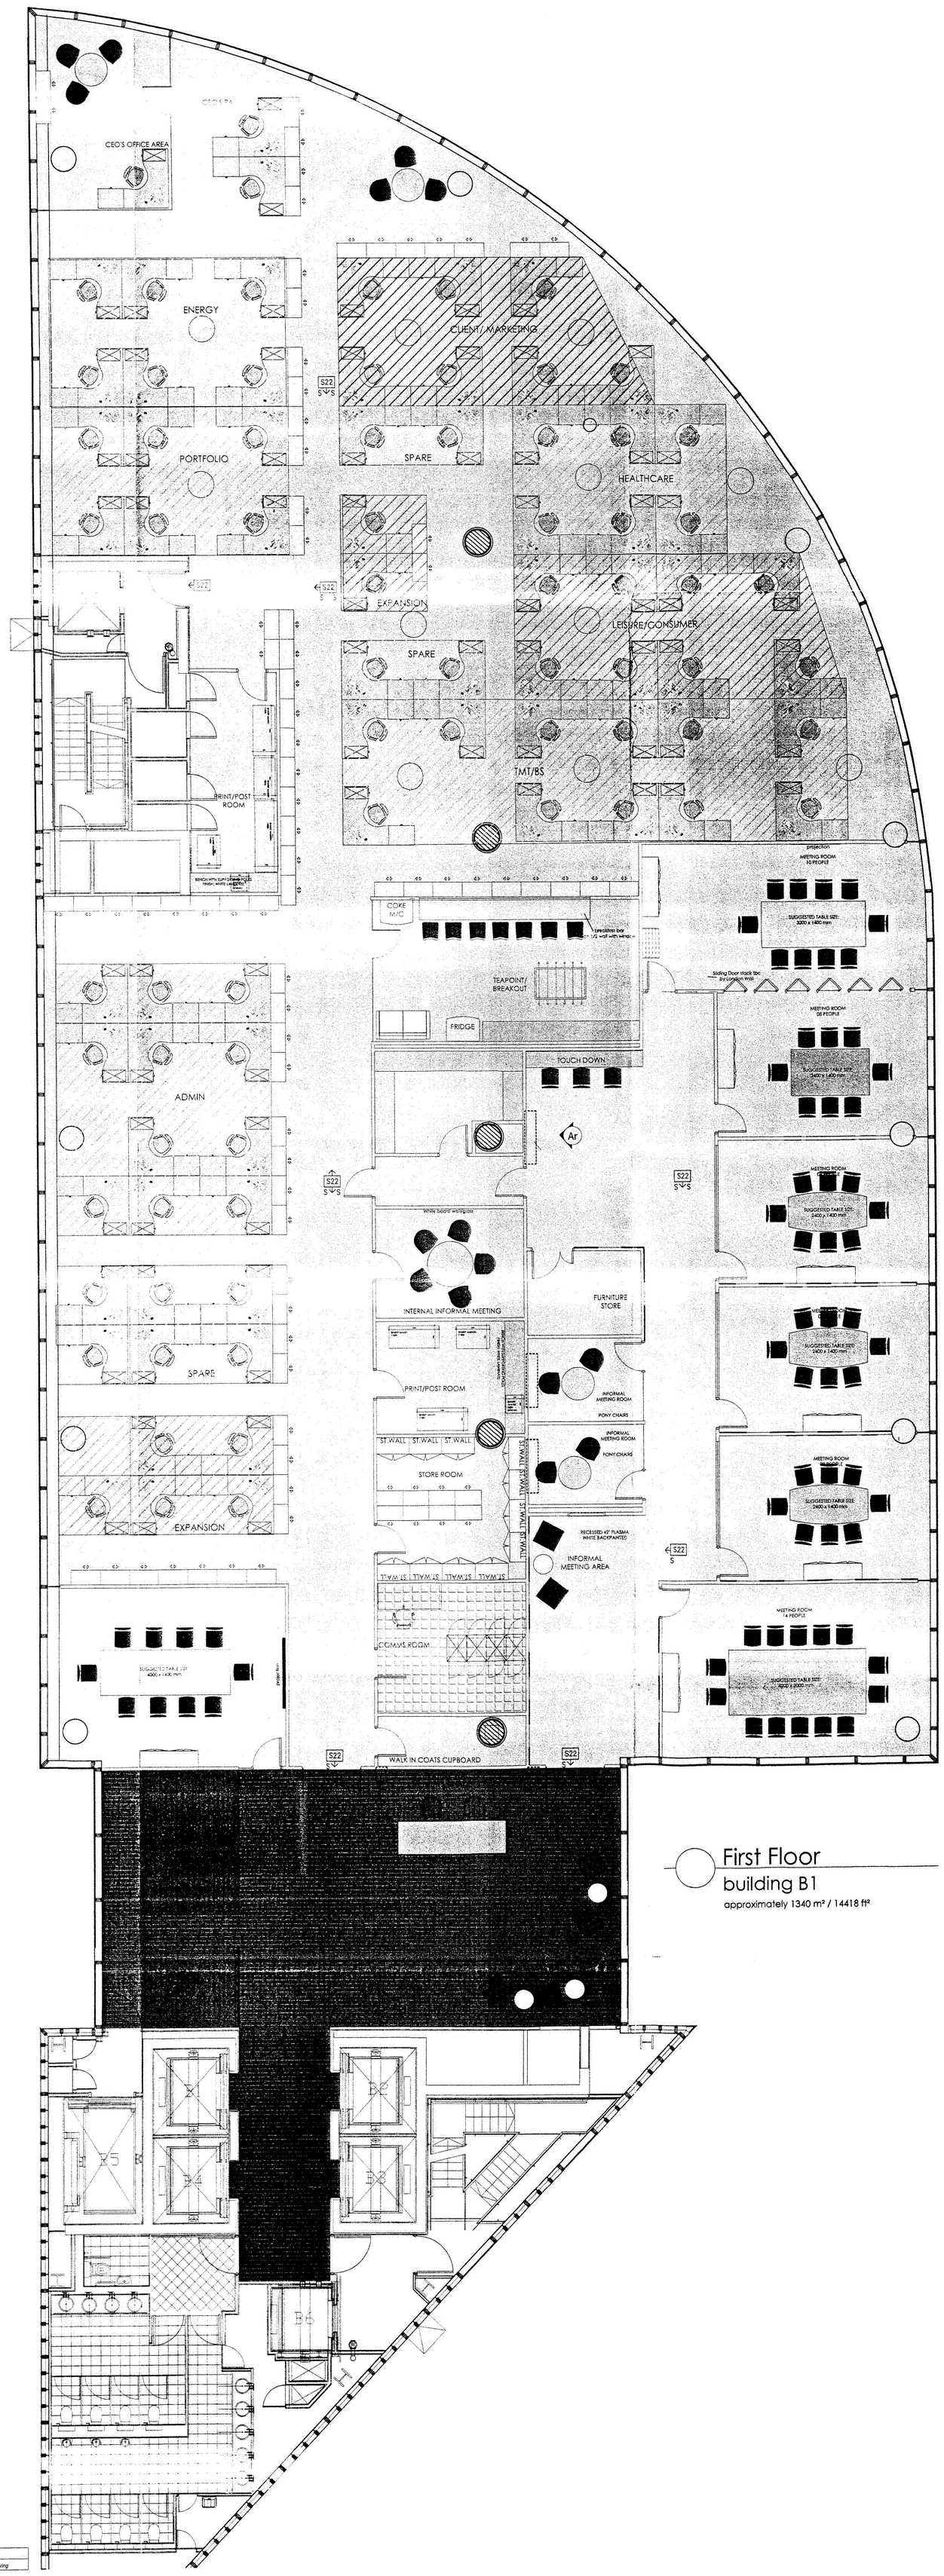

First Floor
building B1
approximately 1340 m² / 14418 ft²

AS-BUILT DRAWING

Cad Ref:	06.0076_HG CAPITAL_GL_AS
Status:	☐ For information ☐ For tender ☐ For construction ☒ As built drawing

CLIENT:
H.G. CAPITAL

ADDRESS:
2 MORE LONDON
RIVERSIDE
LONDON
SE1 2DB

TITLE:
FIRST FLOOR
AS BUILT GENERAL LAYOUT

Dwg No: 06.0076 - 1 - GL AS

bluu solutions limited
Princess House
50-60 Eastcastle Street
London W1W 8EA
t: +44 (0)20 7079 3400
f: +44 (0)20 7323 1723

DESIGN BY	-	MK
DATE	-	25.08.04
SCALE	-	1:100@A1
CAD BY	-	SHK/CP
SIGN OFF	-	

Copyright bluu

NOTES:

All dimensions to be checked on site.
Do not scale from this drawing.
Subject to local authority approval.

Drawing for visual purpose only.
For specification refer to scope of works.

FINISHES CODES & LEGEND

CODE	FINISH	MANUFACTURER
WL/01 TIMBER CLADDING	ZEBRANO VENEER	R.J.A
WL/02 GLASS CLADDING	BACKPAINTED GLASS WHITE	BIG STUDIO
WL/03 OVERALL PAINT	WHITE, RAL 9016	RAL
WL/04 BACKPAINTED GLASS (VARIOUS COLOURS)	SEE DETAIL ELEVATION FOR COLOUR REFERENCE OF INDIVIDUAL ROOM	DULUX 0870 242 1100
WL/05 FOLDING DOOR	B070 BLANC MEGEVE FA	POLYREY
WL/06 SHOWER TILING	WHITE TILE PROJ. 150 x 150 mm	JOHNSON & JOHNSON
L/07 DOOR FINISH	OAK	TBC
WL/07 CLADDING	CLEAR GLASS OR ACRYLIC - CLIENT TBC	TBC

WALL FINISH — WL/
PAINT — /W/
LAMINATE — /LA/
PLASTER FINISH — /PF/
FLOOR FINISH — FF/

Main Office Carpet
REUSE EXISTING — FF/01

Reception Area
Stonehouse tile
Limestone Bateige Azul
300x600 TBC — FF/02

SHOWER TILES
SOLUS TILES
PRIMO MATT
50 X 50 MOSAIC — FF/03

T.Point floor vinyl tile
AMTICO
PLAIN MIST STUD
DB311 — FF/04

Meeting Room Carpet
CHRISTY CARPET
ABACA 9005 Anise — FF/05

ANTI STATIC
BONDED
RAISED FLOOR TILE
TBC — FF/06

150 MM RECESSED SKIRTING

Cad Ref:	06.0075_HG CAPITAL_GL
Status:	☐ For information ☐ For tender ☐ For construction ☒ As built drawing

CLIENT:
H.G. CAPITAL

ADDRESS:
2 MORE LONDON
RIVERSIDE
LONDON
SE1 2DB

TITLE:
FIRST FLOOR
AS BUILT FINISHES LAYOUT

bluu solutions limited
Princess House
50-60 Eastcastle Street
London W1W 8EA
t: +44 (0)20 7079 3400
f: +44 (0)20 7323 1723

DESIGN BY	-	MK
DATE	-	25.08.04
SCALE	-	1:100@A1
CAD BY	-	SHK/CP
SIGN OFF	-	


Dwg No: 06.0076 - 1 - FL AS

Copyright bluu

NOTES:

All dimensions to be checked on site.
Do not scale from this drawing.
Subject to local authority approval.

Drawing for visual purpose only.
For specification refer to scope of works.

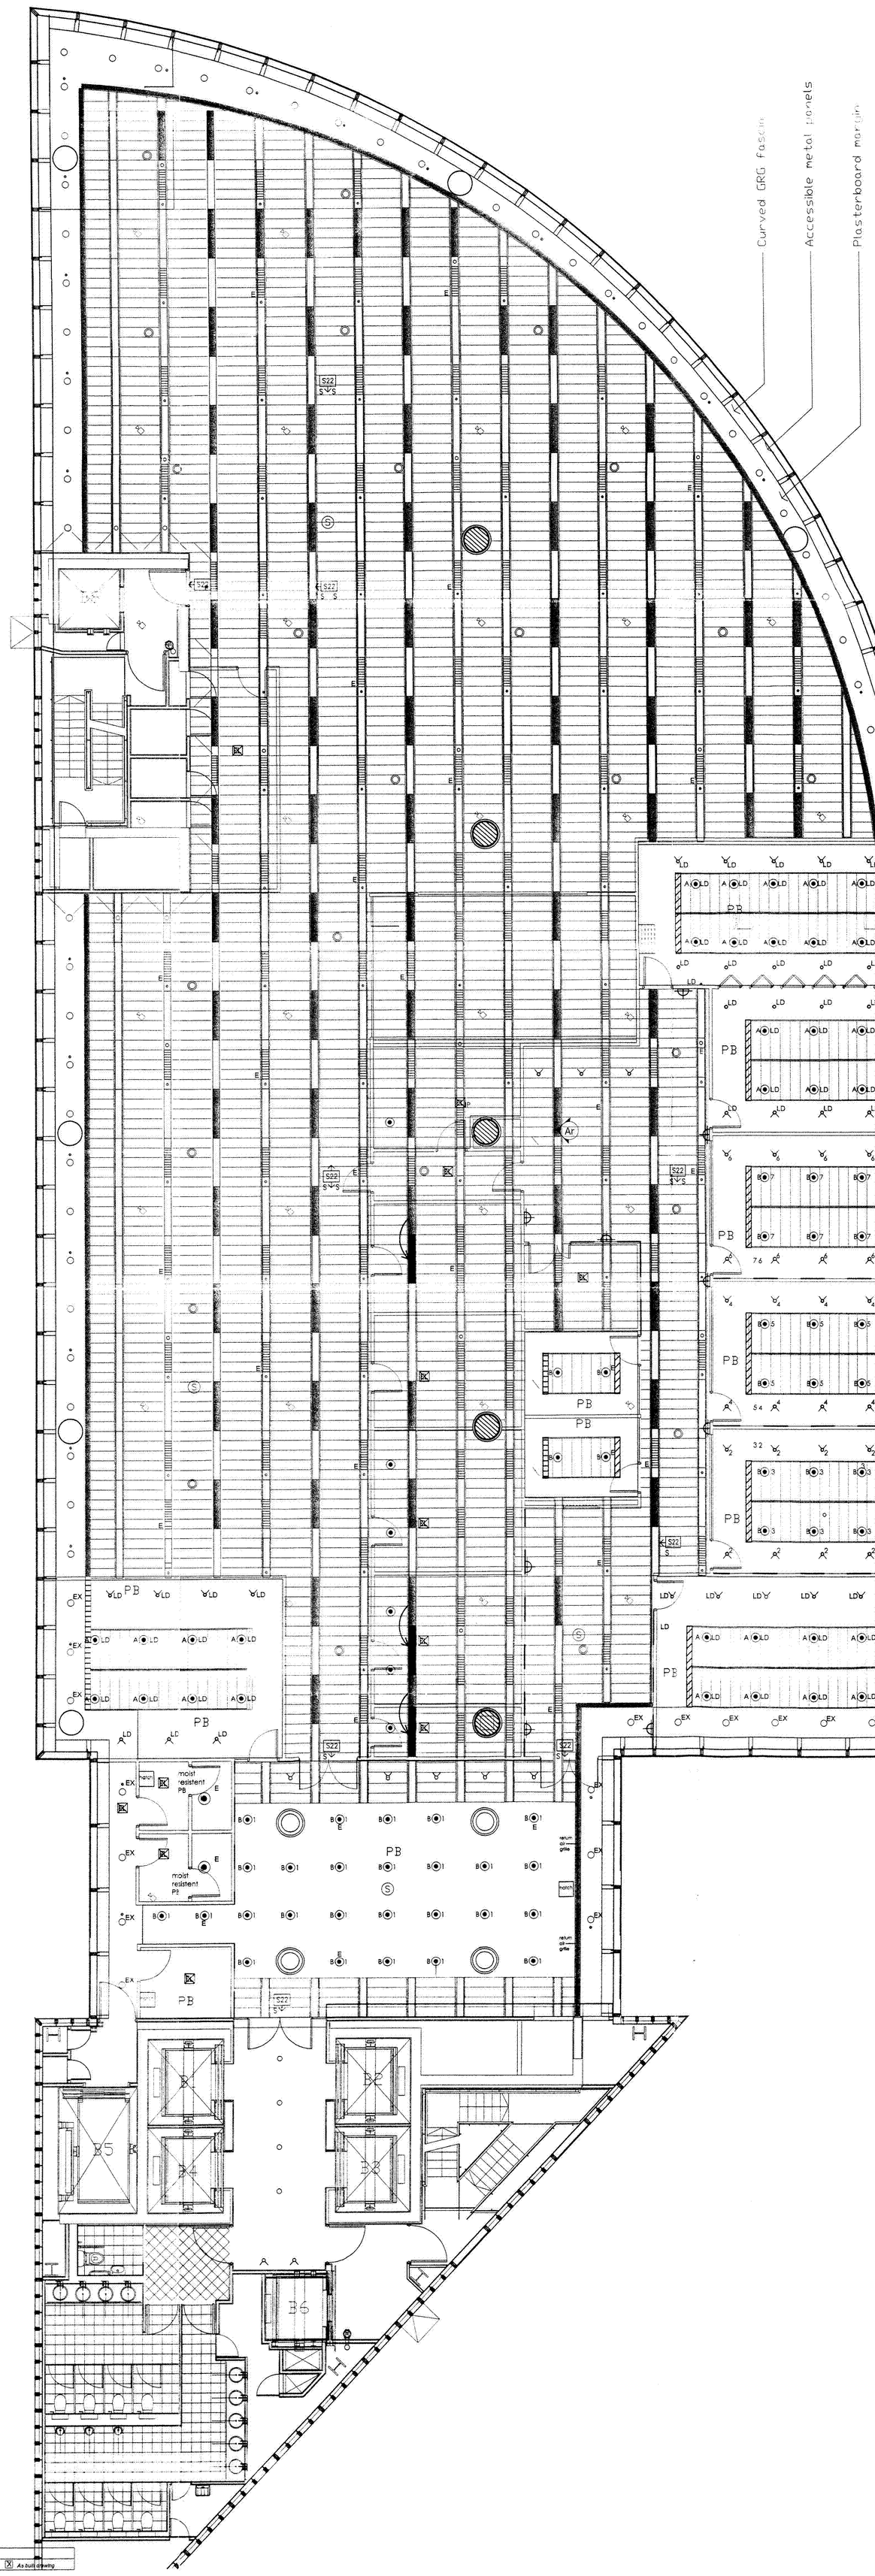

LEGEND - EXISTING

- Asymmetrical fluorescent recessed wallwasher
- Circular downlights
- Circular wallwashers
- Linear diffusor grille suitable for extract and supply length of grille to match light fitting
- Linear metal ceiling system 1500mm grid 1200x300mm approx planks
- Hidden loudspeaker on a 6x6m grid
- 100mm diameter smoke detectors on a 9x9m grid
- 75 mm diameter sprinklers on a 3x3m grid
- Linear diffuser grille continuous at perimeter only

- ADDITIONAL NEW WALL LIGHT POSITIONS
- RETURN AIR GRILL
- SUPPLY AIR GRILL
- GRILL POSITION
- NEW GRID POSITION

LEGEND - NEW LIGHTING LAYOUT

- DIRECTIONAL SPOT LIGHT
- DELTA LIGHT - MAESTRO S 236 OR EQUIVALENT
- COMPACT FLUORESCENT SPOT LIGHT
- PB — CEILING IN AREA TO BE PLASTERBOARD FINISH

NOTE:
SPRINKLER and SD to suit new layout
Existing lighting and ventilation grilles to be moved to suit new layout
Access panels to be placed to suit vent location!! (STILL TO BE INCLUDED)

HIGH LEVEL SERVICES LEGEND

	EXISTING FLUORESCENT FITTING E = EM 3 HOUR NM CONVERSION
	COMPACT FLUORESCENT FITTING FINISHED IN WHITE A = TYPE A 1 = SWITCH 1
	11 WATT COMPACT FLUORESCENT FITTING FINISHED IN WHITE 1 = SWITCH 1
	DIRECTION LV FITTING FINISHED IN WHITE WITH 35 WATT LAMP
EX	EXISTING PERIMETER LIGHT FITTING TO REMAIN IN POISTION AND SWITCHED AS EXISTING LAYOUT
LD	LUTRON DIMMER CONTROL WALL MOUNTED LD = LIGHT FITTING CONTROLLED BY ABOVE
	STANDARD LIGHT SWITCH WALL MOUNTED
PD	PIR LIGHTING CONTROL TO OPEN PLAN CEILING MOUNTED
EM	EM FITTING 3 HOUR NM SURFACE MOUNTED IP = RATED TO SHOWER / KITCHEN ENCLOSURES
E	WALL LIGHT FITTING SWITCHED WITH MAIN LIGHTING SYSTEM - FINISHED AS SUPPLIED IMAGES E = EM FITTING 3 HOUR NM

NOTES:

THE LIGHTING SYSTEM IN MEETING ROOM 6 TO BE EQUIPPED WITH TAKE CONTROL UNIT TO FOLDING WALL.

BSL TO PROVIDE ATTENDANCE TO CEILINGS AND LIGHTING INFILL PLATE MODIFICATIONS.

Cad Ref:	06.0076_HG CAPITAL_GL_AS
Status:	☐ For information ☐ For tender ☐ For construction ☒ As built drawing

CLIENT:
H.G. CAPITAL

ADDRESS:
2 MORE LONDON
RIVERSIDE
LONDON
SE1 2DB

TITLE:
FIRST FLOOR
AS BUILT CEILING LAYOUT

bluu solutions limited
Princess House
50-60 Eastcastle Street
London W1W 8EA
t: +44 (0)20 7079 3400
f: +44 (0)20 7323 1723

DESIGN BY	-	MK
DATE	-	25.08.04
SCALE	-	1:100@A1
CAD BY	-	SHK/CP
SIGN OFF	-	


Dwg No: 06.0076 - 1 - CL AS

Copyright bluu

NOTES:


All dimensions to be checked on site.
Do not scale from this drawing.
Subject to local authority approval.

Drawing for visual purpose only.
For specification refer to scope of works.

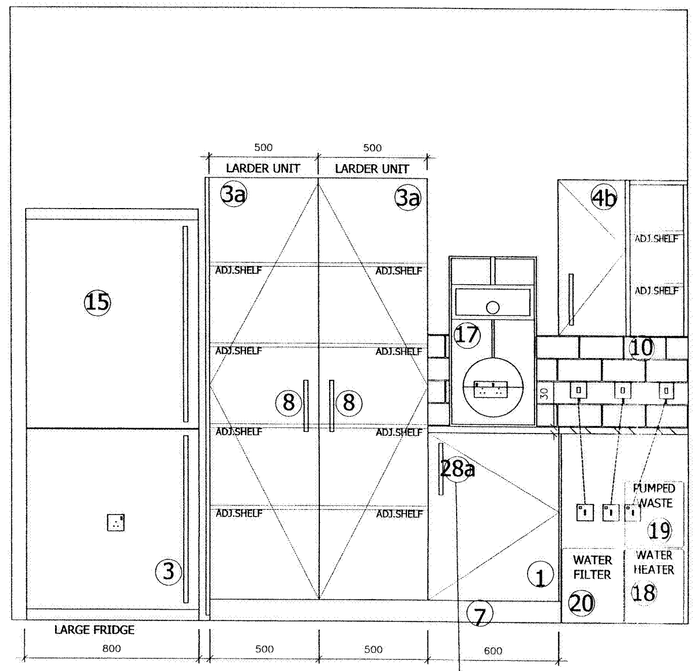


ELEVATION A


INTEGRATED VIVREAU WATER FILTER UNIT TO SIT UNDERNEATH COFFEE MACHINE - TAP TO LOCATED NEXT TO SINK

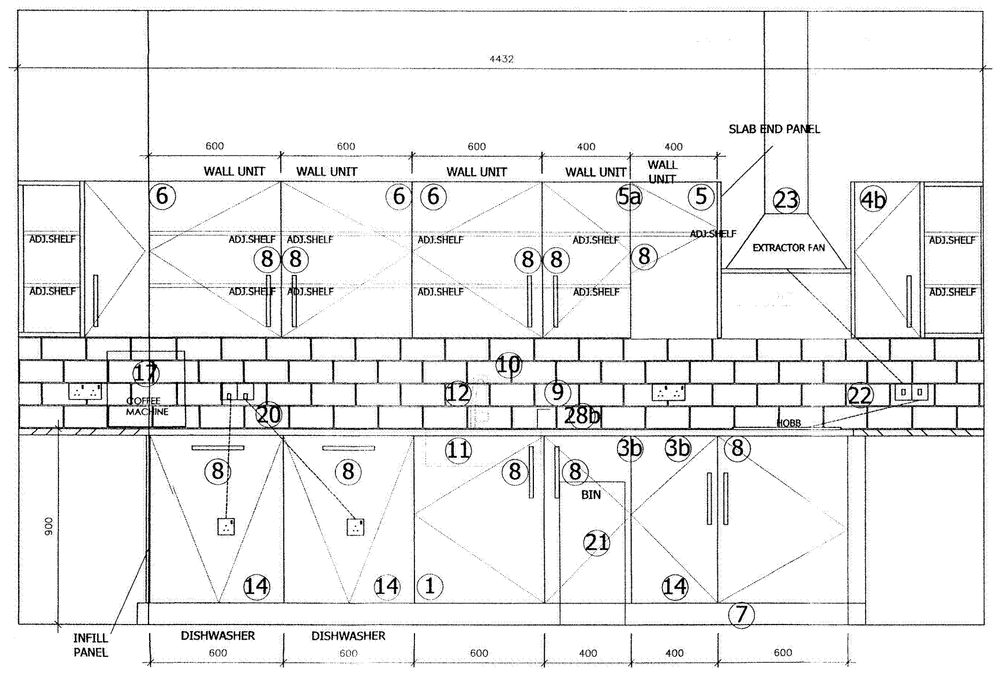

ELEVATION B

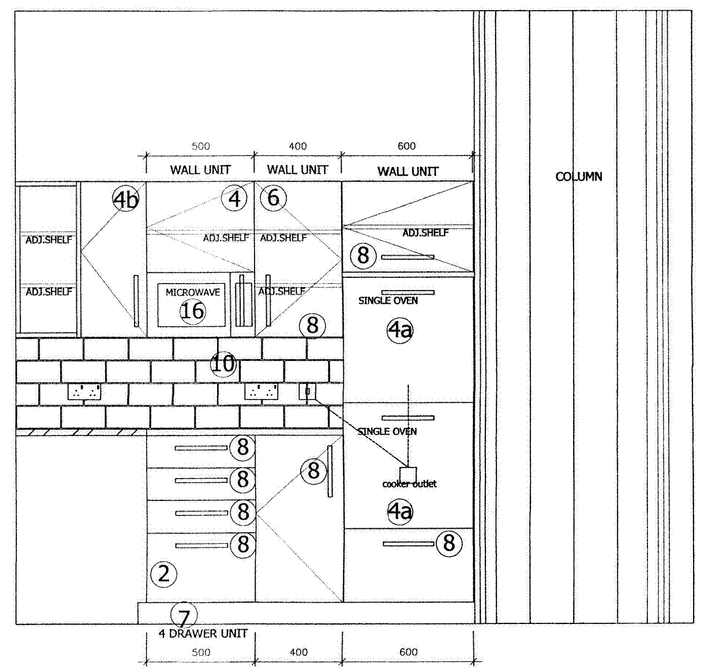

ELEVATION C

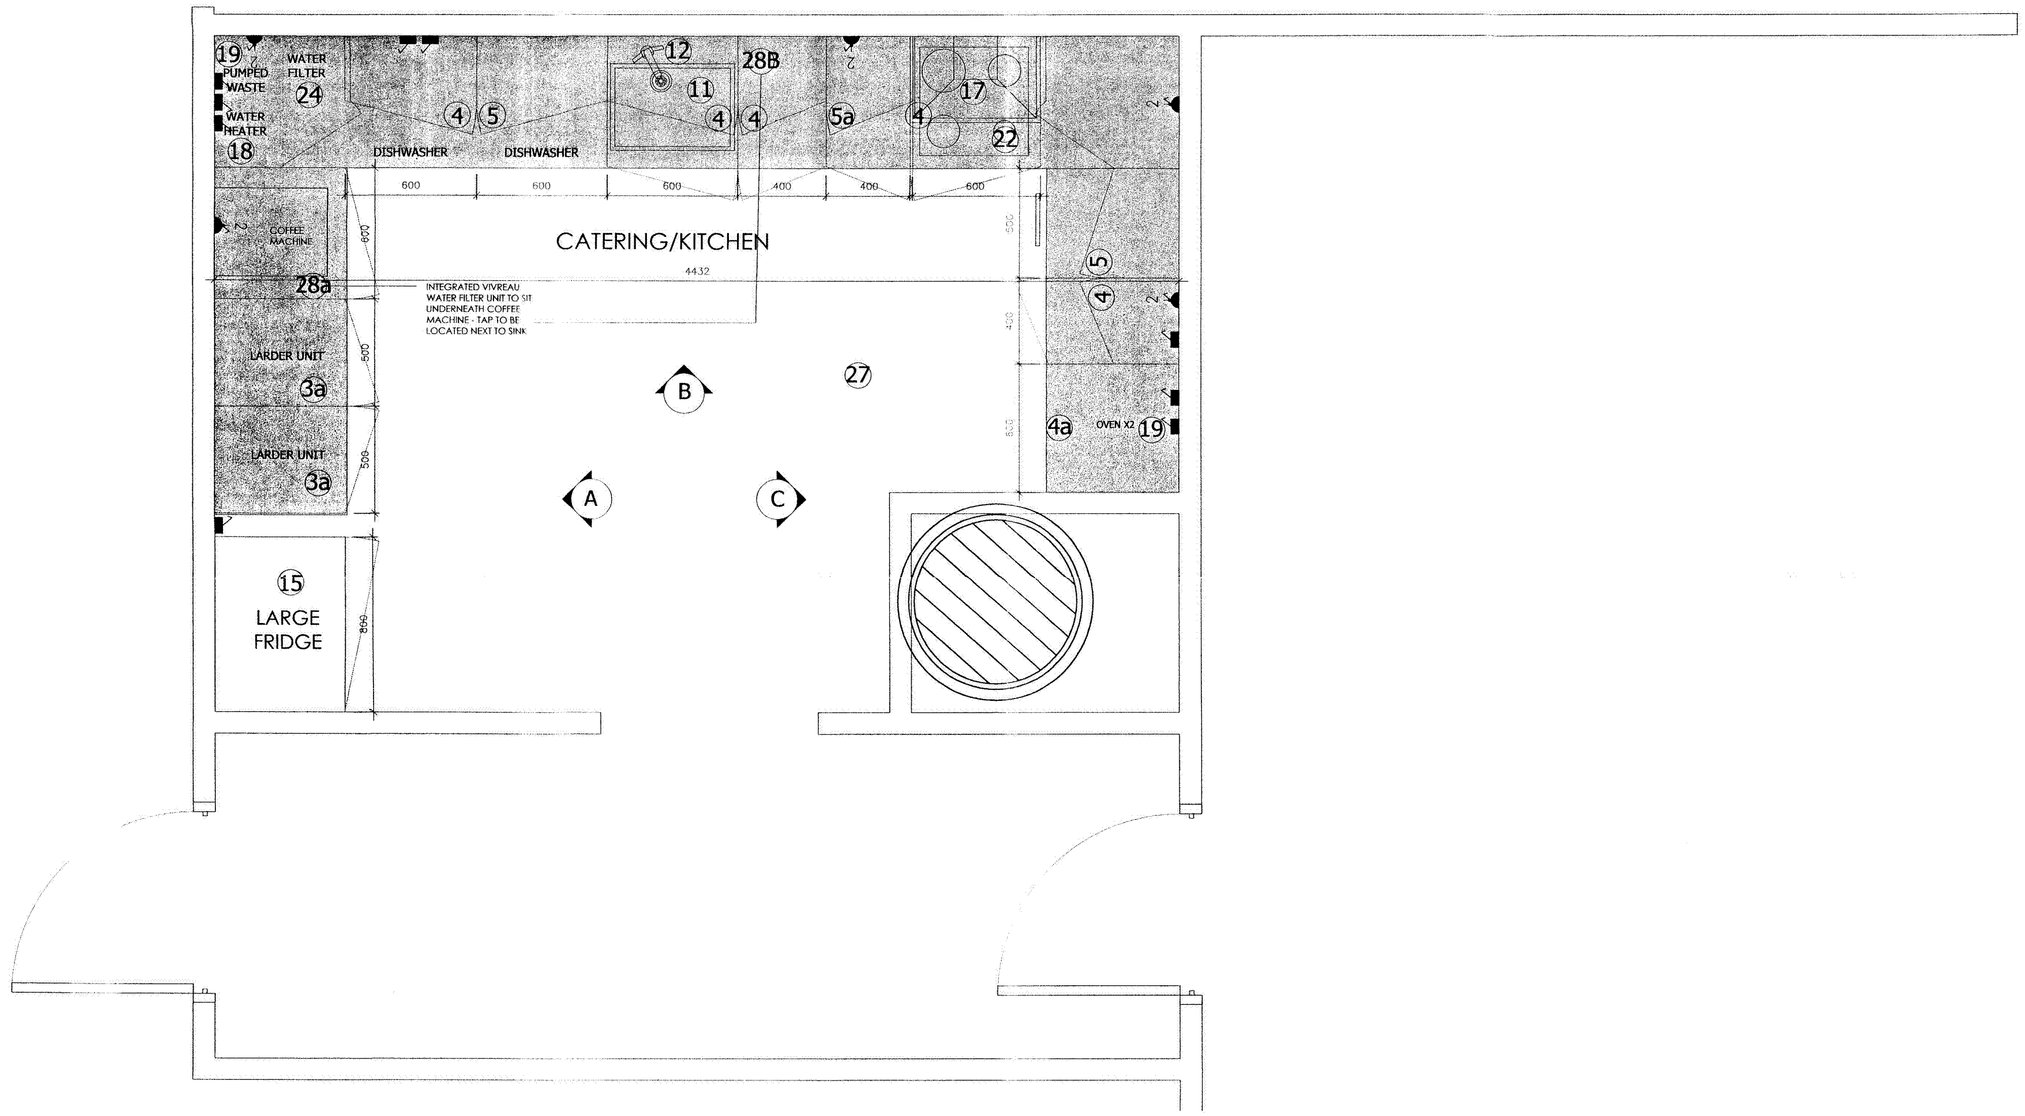

TEAPOINT 2: OPEN PLAN - LEGEND

2	NEW DOUBLE SWITCHED SOCKET OUTLET – BRUSHED STAINLESS STEEL FINISH
1	NEW SINGLE SWITCHED SOCKET OUTLET – BRUSHED STAINLESS STEEL FINISH
1	NEW SINGLE SOCKET WITH SWITCHED SPUR – BRUSHED STAINLESS STEEL FINISH
X / Y	NEW FLOOR SERVICE BOX X – NO OF POWER OUTLETS Y – NO OF DATA OUTLETS
	UNIT SPECIFICATION Magnet Trade - Aspen or Howdens Glendevon White.N.B: Units to be installed on 90mm legs.
1	Wide Single Floor Unit 600w x 822h x 500d
1a	Blank Drawer/Door Floor Unit 600w x 822h x 500d
2	4 Drawer Floor Unit 500w x 822h x 500d
3	Wide Single Floor Unit 500w x 822h x 500d
3a	Wide Single Larder Unit 500w x 822h x 500d
3b	Single Floor Unit 400w x 822h x 500d
4	Wide Single Tall Wall Unit 600w x 720h x 300d
4a	OVEN: NEFF B4540
4b	Corner Unit 600w x 720h x 300d
5	Wide Single Tall Wall Unit 500w x 720h x 300d
5a	Wide Single Tall Wall Unit 400w x 720h x 300d
6	Wide Single Tall Wall Unit 600w x 720h x 300d
7	Plinth: To match unit doors, scribed to suit gap under units once installed.
8	Handles: Magnet 237mm Stainless Steel Bar.
9	Worktop: 30mm Thick, Finish - METALLIN PP 4836 CR
10	Splashback: JOHNSON & JOHNSON, White, SIZE: 200 x 100 Brick bonded tile
11	Sink Astra cast onya 570x 430 mm, Single bowl
12	Tap: Magnet - Neptune.
13	Slab End panel: TBC, effect finish to match unit doors.
14	Integrated Dishwasher: Spec from Magnet Trade
15	Large Fridge/Freezer: Spec from Magnet Trade.
16	Microwave: NEFF H5642
17	Coffee Machine: 'Select Cup' machine supplied by Select Drinks, dims: 790 (h), 400 (w), 519 (d), .
18	Water Heater
19	Pumped Waste
20	Bench Top Filtered Water Unit - Clients Own
21	Bin
22	Intergrated Hobb: NEFF T4543
23	Extractor Hood: NEFF D8712
24	Water filter
27	Floor Covering: Amtico Pure Plain Mist Stud - PN 311
28	28a VIVREAU WATER UNIT / 28 b VIVREAU TAP

Origin:	☐ CAD	☐ HAND	☐ SURVEY	
Cad Ref:	05.0076_HGCAPITAL_TP2_AS			
Status:	☐ For Information	☐ For tender	☐ For construction	☒ As built drawing

CLIENT:
HG CAPITAL

ADDRESS:
2 MORE LONDON
RIVERSIDE
LONDON
SE1 2DB

TITLE:
AS BUILT CATERING

bluu solutions limited
Princess House
50-60 Eastcastle Street
London W1W 8EA
t: +44 (0)20 7079 3400
f: +44 (0)20 7323 1723

DESIGN BY	-	MK
DATE	-	07_09_06
SCALE	-	1:20@A1
CAD BY	-	CP
SIGN OFF	-	

Dwg No: 05.0076 – 1 – TP2 AS

Copyright bluu