DRAWING & DOCUMENT ISSUE SHEET

Originator	Name	DTZ Debenham Tie Leung	Originators Reference	DTZ	Sheet
	Office	3-5 SWALLOW PLACE, LONDON SW1 4NA	6012665		1 OF 1

DTZ Debenham Tie Leung
International Property Advisors

Montagu Private Equity
No. 2 More London, SE1

Date of issue
Day 25 27
Month 09 09
Year 06 06

Description	Scale	Size	No.	Amendments (Or = original)
DTZ DEBENHAM TIE LEUNG DOCUMENTS & DRAWINGS:-				
3rd FLOOR				
EXISTING GENERAL LAYOUT/STRIP OUT	1:100	A1	3.01	
NEW RAISED ACCESS FLOOR LAYOUT	1:100	A1	3.02	
PROPOSED FURNITURE & GENERAL LAYOUT	1:100	A1	3.04	
PROPOSED PARTITION LAYOUT	1:100	A1	3.05	
PROPOSED FLOOR FINISHES LAYOUT	1:100	A1	3.06	
PROPOSED DOOR & JOINERY LAYOUT	1:100	A1	3.07	
PROPOSED REFLECTED CEILING PLAN	1:100	A1	3.08	

Distribution		Number of Copies
Hraham Hislop	Montagu Private Equity	
Cathy Clifford	Montagu Private Equity	
Mark Rabbett	Chapman Bathurst	
Adrian Speller	Chapman Bathurst	
Jim Watret	More London Developments	
Kevin Flaye	Building Manager	
	CONTRACTOR	
Andrew Lowe	HCD APPROVED INSPECTORS	
	Lawrence Graham	4
	Landlord	3

Key

Number=Number off copies
N = Negative
X = Issue sheet only
* = Always on distribution
D = Disc
R = A3 Reduced
E = Electronic transfer (e-mail)


Key for issue purposes

P = Preliminary for Pricing
I = Information
Q = Quantities
C = Construction
T = Tender
A = Approval
RV = Review
AS = Return 'A' Status
BS = Return 'B' Status
CS = Return 'C' Status

Purpose of Issue

SIGNED *N. R. Denman*

DATED

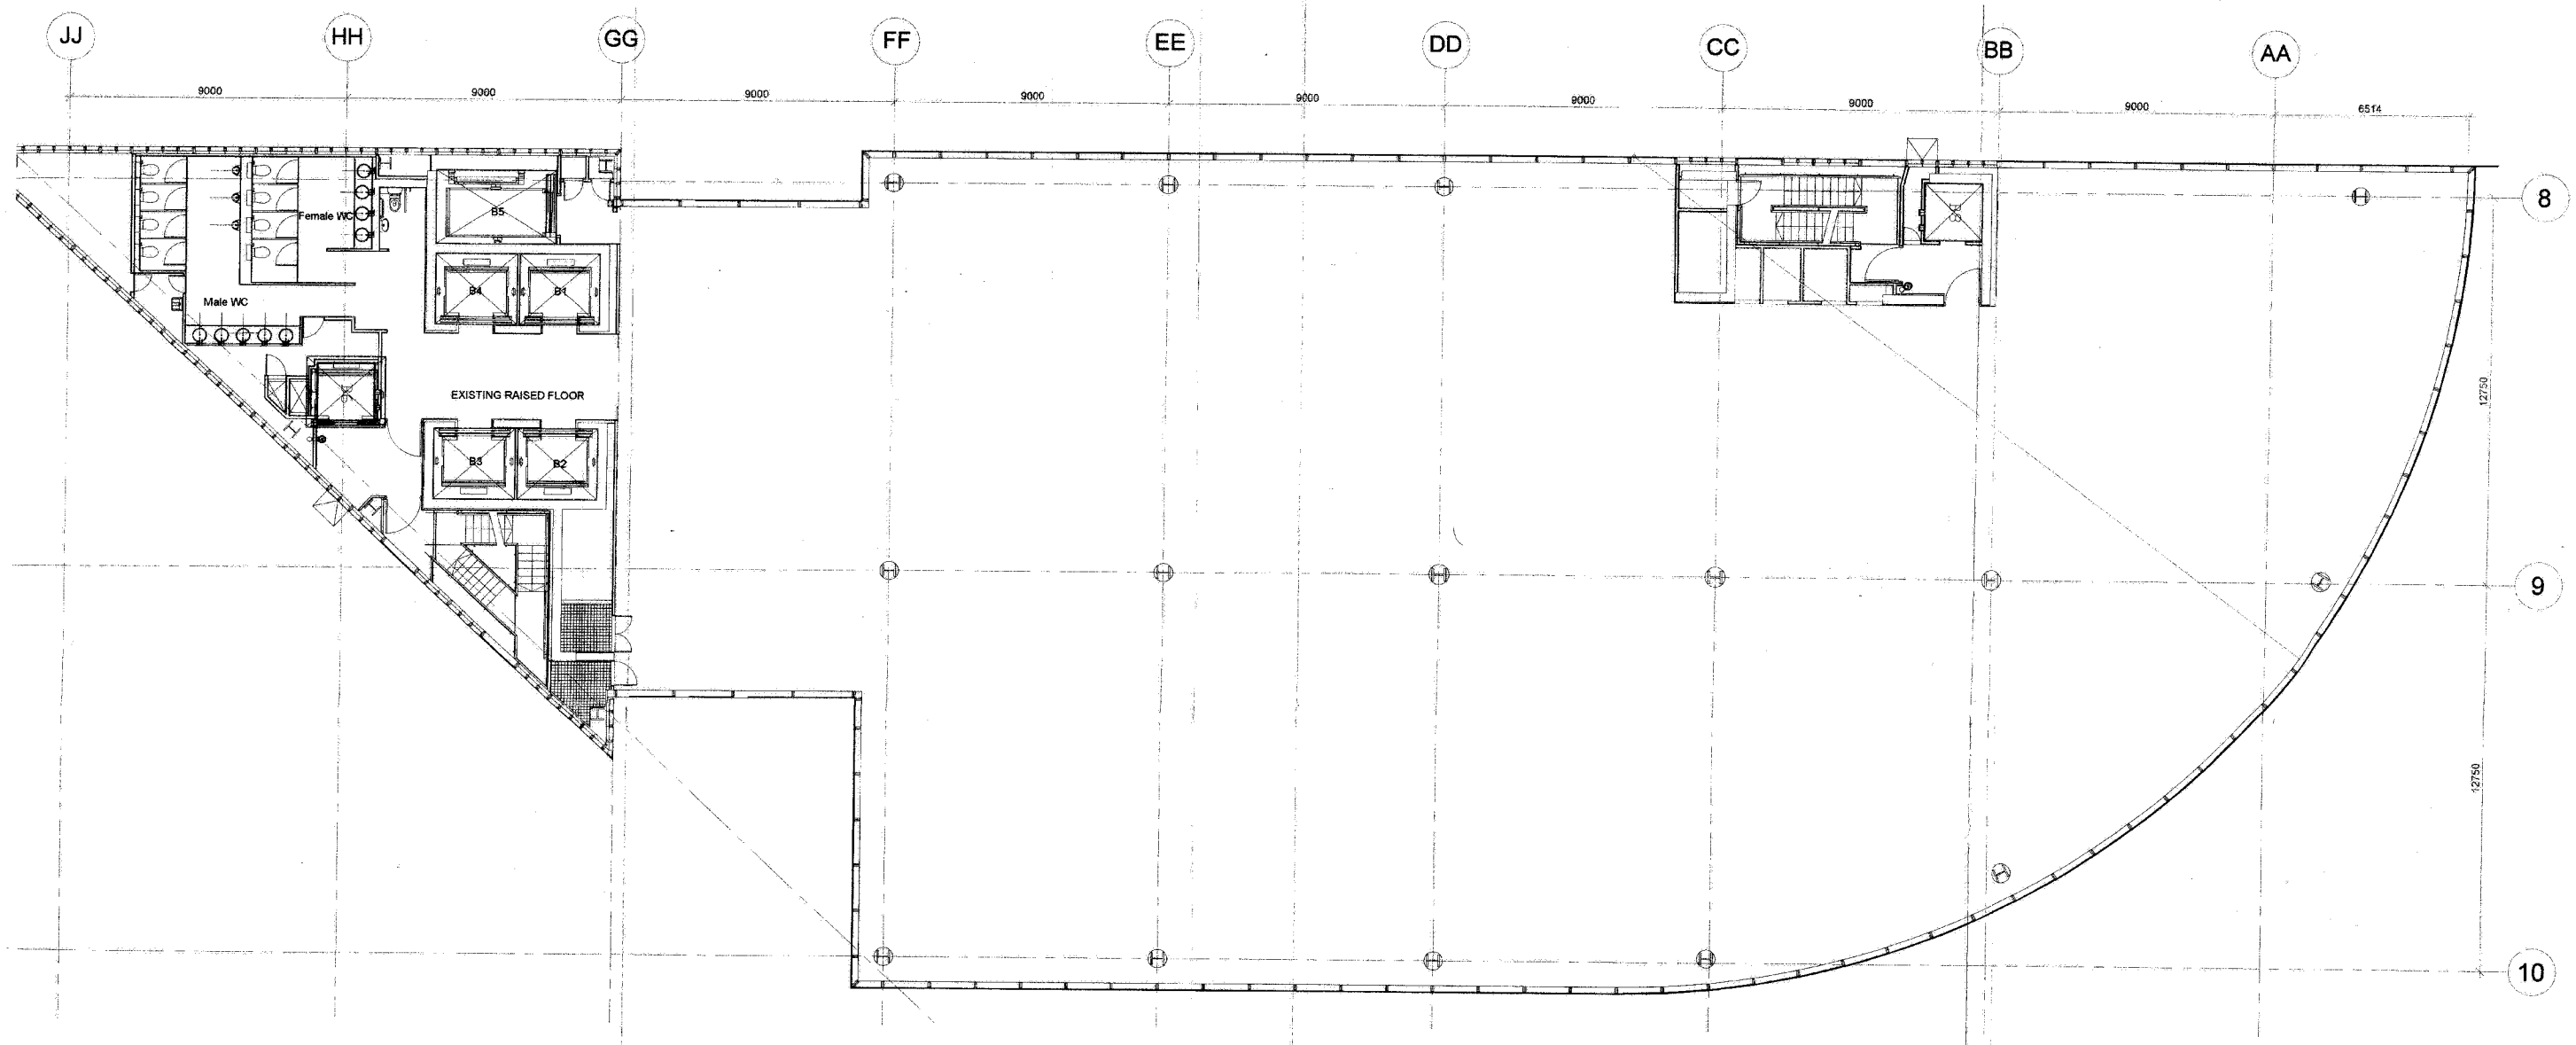

Notes

1. Do not scale to ascertain dimensions
2. All dimensions to be checked and verified on site prior to commencement of work
3. This drawing to be read in conjunction with the specification and other drawings
4. Copyright for all designs and drawings in whole or in part shall remain with the Surveyors in accordance with The Copyright Act.

REV	DATE	DESCRIPTION	INITIALS	REV	DATE	DESCRIPTION	INITIALS	REV	DATE	DESCRIPTION	INITIALS	REV	DATE	DESCRIPTION	INITIALS

DATE PLOTTED :
DOS FILENAME : S:/GARY LAGDON/CURRENT JOBS/(MK DENMAN)/MONTAGU PRIVATE EQUITY/THIRD FLOOR
SAVED VIEW NAME :
XREFERENCES :
PLOT No :

DTZ Debenham Tie Leung
International Property Advisors

3-5 Swallow Place, London W1A 4NA
tel: 020 7408 1161 Fax: 020 7493 0637


CLIENT: MONTAGU PRIVATE EQUITY

PROJECT: 2 MORE LONDON
THIRD FLOOR

DRAWING: EXISTING GENERAL LAYOUT
STRIP OUT

DRWG No. 06012265 3.01 CAD REF:

SCALE: 1:100
DATE: 25 SEPTEMBER 2006
DRAWN: CJT
APPROVED:
REVISION:

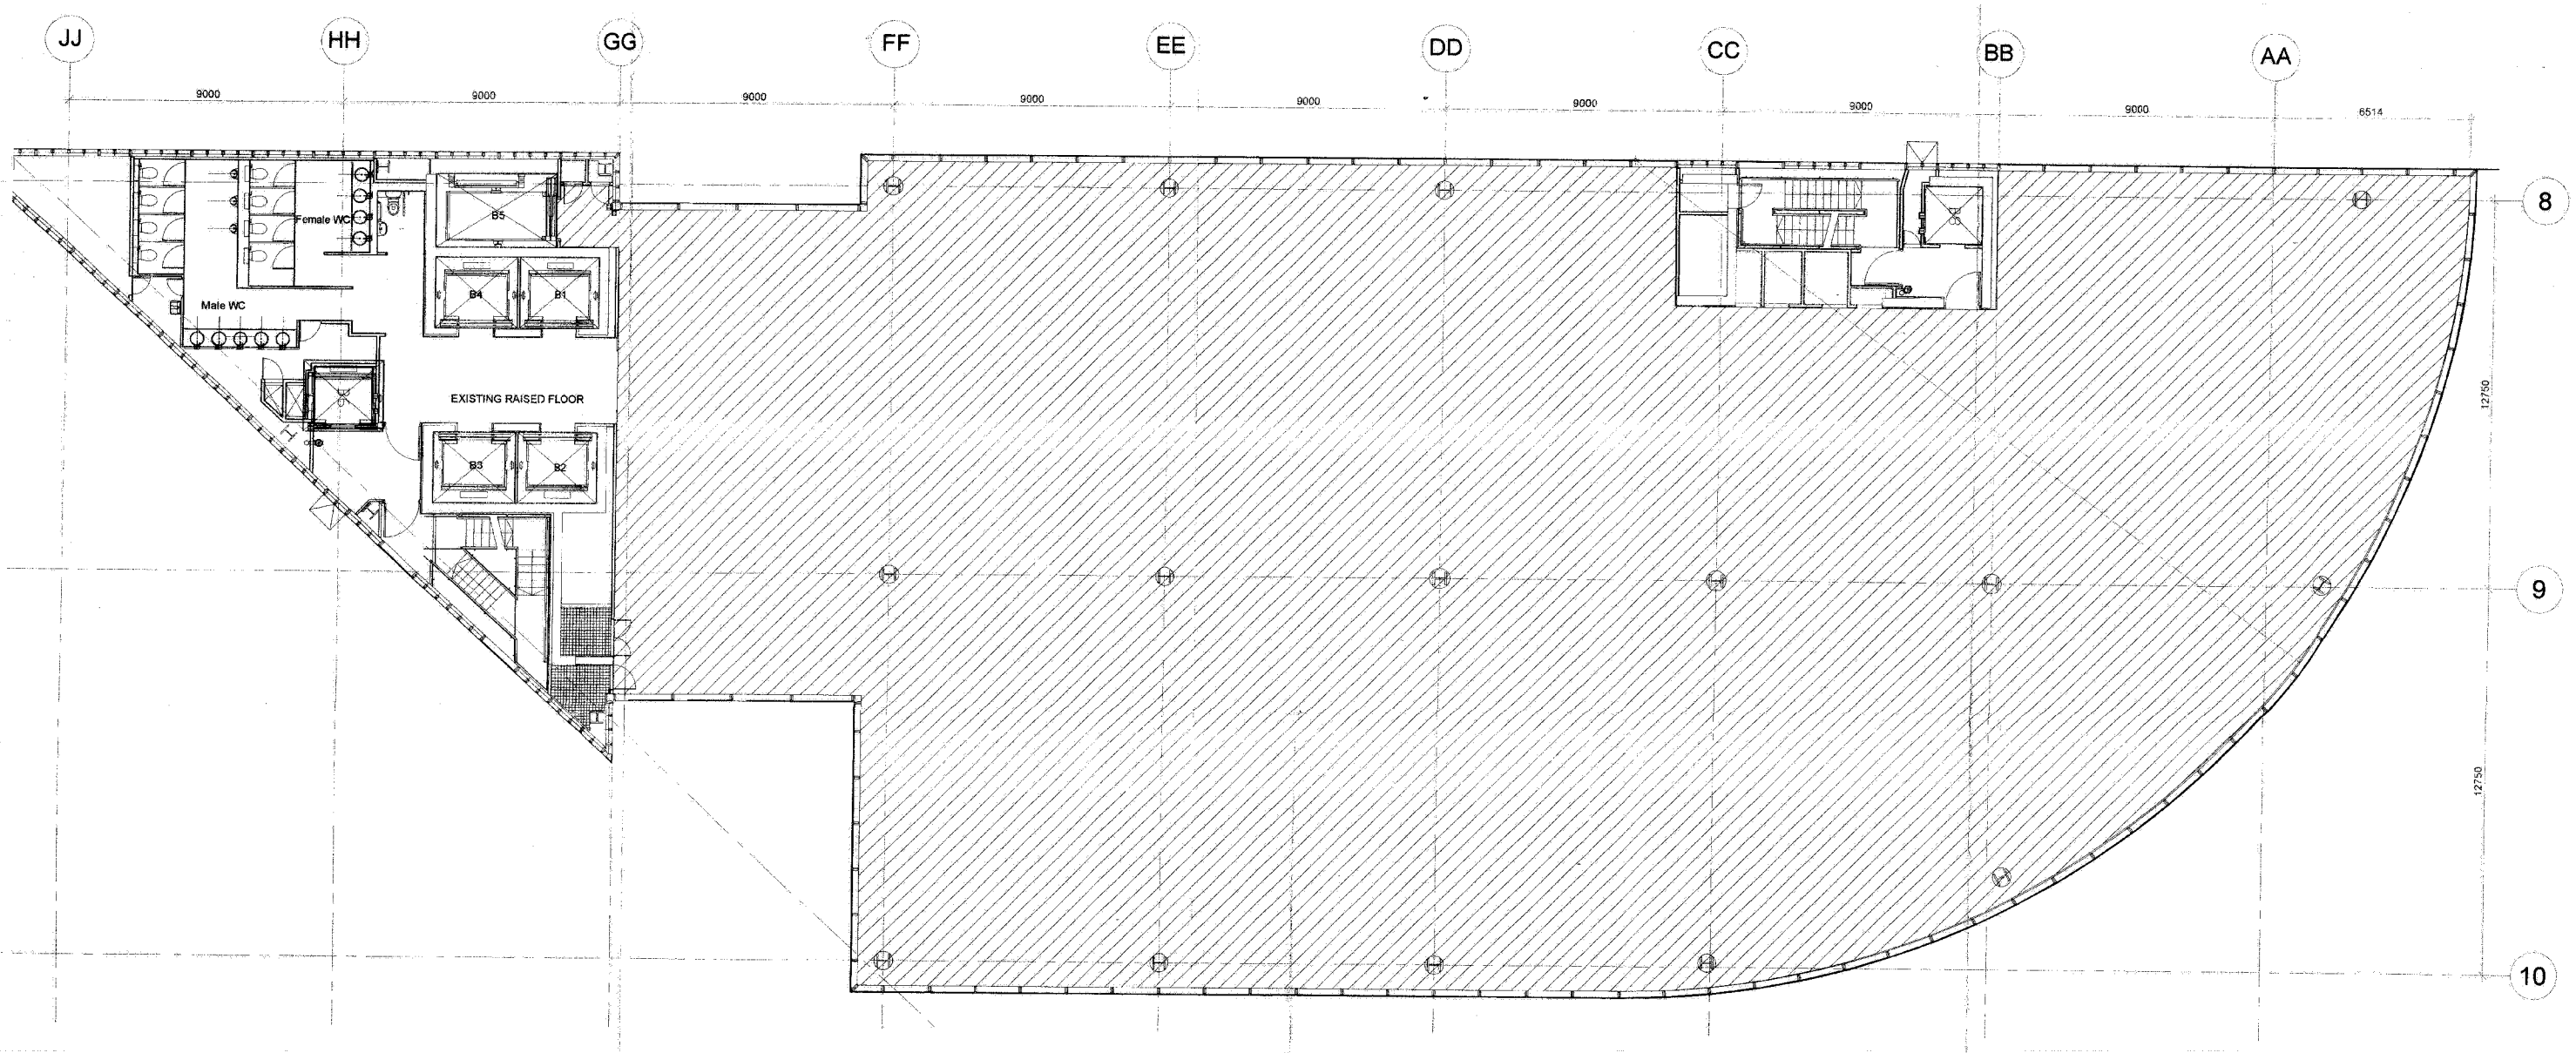

NOTE:
Contractor to supply and install the new raised access floor with nominal overall depth of 150mm inclusive of tilethickness.
A minimum clear dimension of 100mm will be maintained throughout the raised floor void.
A medium grade raised access floor system to PSA performance specification reference MOB PF2 PS 1990 with 600mm x 600mm tiles (metal wrapped) will be required.
Immediately in front of the goods lift - heavy grade flooring will be required
A 2 Coat coloured floor sealer will be applied to the concrete sub floor prior to installation of the raised access floor and all necessary plenum barriers, fire breaks and closure details will be included as required to suit occupation
refer to finishes schedule, specification and landlords CAT A specifications.
Class '0' Foam to be applied to perimetor of new raised access floor

LEGEND
EXTENT OF THE NEW RAISED FLOOR


Notes
1. Do not scale to ascertain dimensions
2. All dimensions to be checked and verified on site prior to commencement of work
3. This drawing to be read in conjunction with the specification and other drawings
4. Copyright for all designs and drawings in whole or in part shall remain with the Surveyors in accordance with The Copyright Act.

REV	DATE	DESCRIPTION	INITIALS
REV	DATE	DESCRIPTION	INITIALS
REV	DATE	DESCRIPTION	INITIALS
REV	DATE	DESCRIPTION	INITIALS

DATE PLOTTED :
DOS FILENAME : S:/GARY LADDON/CURRENT JOBS/(INK DENHAM)/MONTAGU PRIVATE EQUITY/THIRD FLOOR
SAVED VIEW NAME :
XREFERENCES :
PLOT No :

DTZ Debenham Tie Leung
International Property Advisors
QS160
3-5 Swallow Place, London W1A 4NA
tel: 020 7408 1161 fax: 020 7493 0937

CLIENT: MONTAGU PRIVATE EQUITY
PROJECT: 2 MORE LONDON THIRD FLOOR
DRAWING: NEW RAISED ACCESS FLOOR LAYOUT
DRNG No. 06012265 CAD REF: 3.02
SCALE: 1:100
DATE: 25 SEPTEMBER 2006
DRAWN: E.R.
APPROVED:
REVISION:

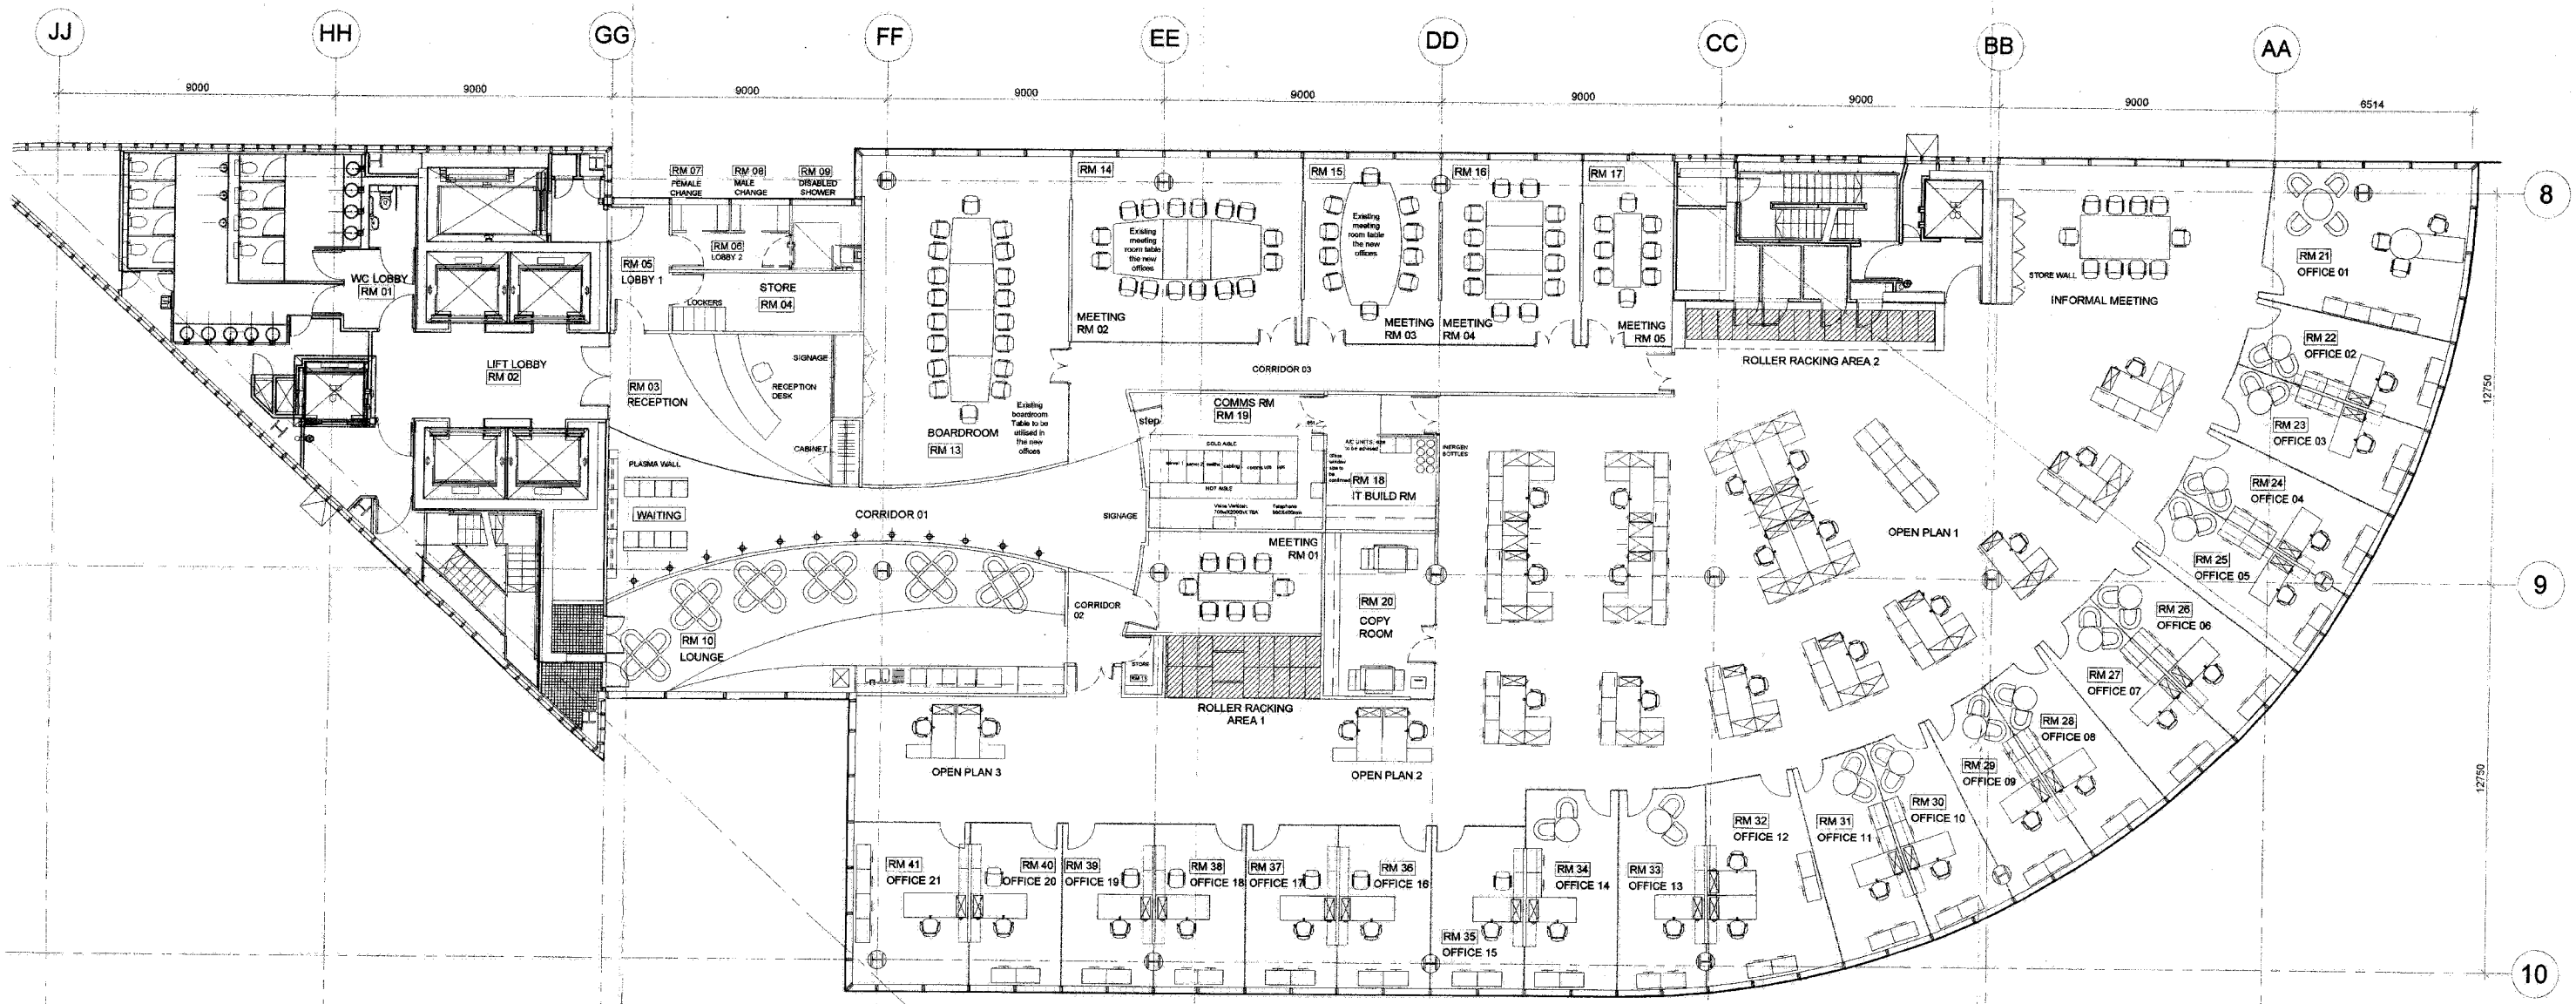

NOTE:

Furniture by others unless identified

Mobile storage units to be supplied & installed by main contractor.

Mobile storage units . Contractor to make all neccessary structural modifications

Notes
1. Do not scale to ascertain dimensions
2. All dimensions to be checked and verified on site prior to commencement of work
3. This drawing to be read in conjunction with the specification and other drawings
4. Copyright for all designs and drawings in whole or in part shall remain with the Surveyors in accordance with The Copyright Act.

REV	DATE	DESCRIPTION	INITIALS

DATE PLOTTED :
DOS FILENAME : S:/GARY LAGDON/CURRENT JOBS/(NIK DENMAN)/MONTAGU PRIVATE EQUITY/THIRD FLOOR
SAVED VIEW NAME :
XREFERENCES :
PLOT No :

DTZ Debenham Tie Leung
International Property Advisers
3-5 Swallow Place, London W1A 4NA
tel: 020 7408 1161 fax: 020 7493 0837

CLIENT: MONTAGU PRIVATE EQUITY

PROJECT: 2 MORE LONDON
THIRD FLOOR

DRAWING: PROPOSED FURNITURE
& GENERAL LAYOUT

DRWG No.: 06012765 3.04 CAD REF:


SCALE: 1:100

DATE: 25 SEPTEMBER 2006

DRAWN: C.L

APPROVED:

REVISION:

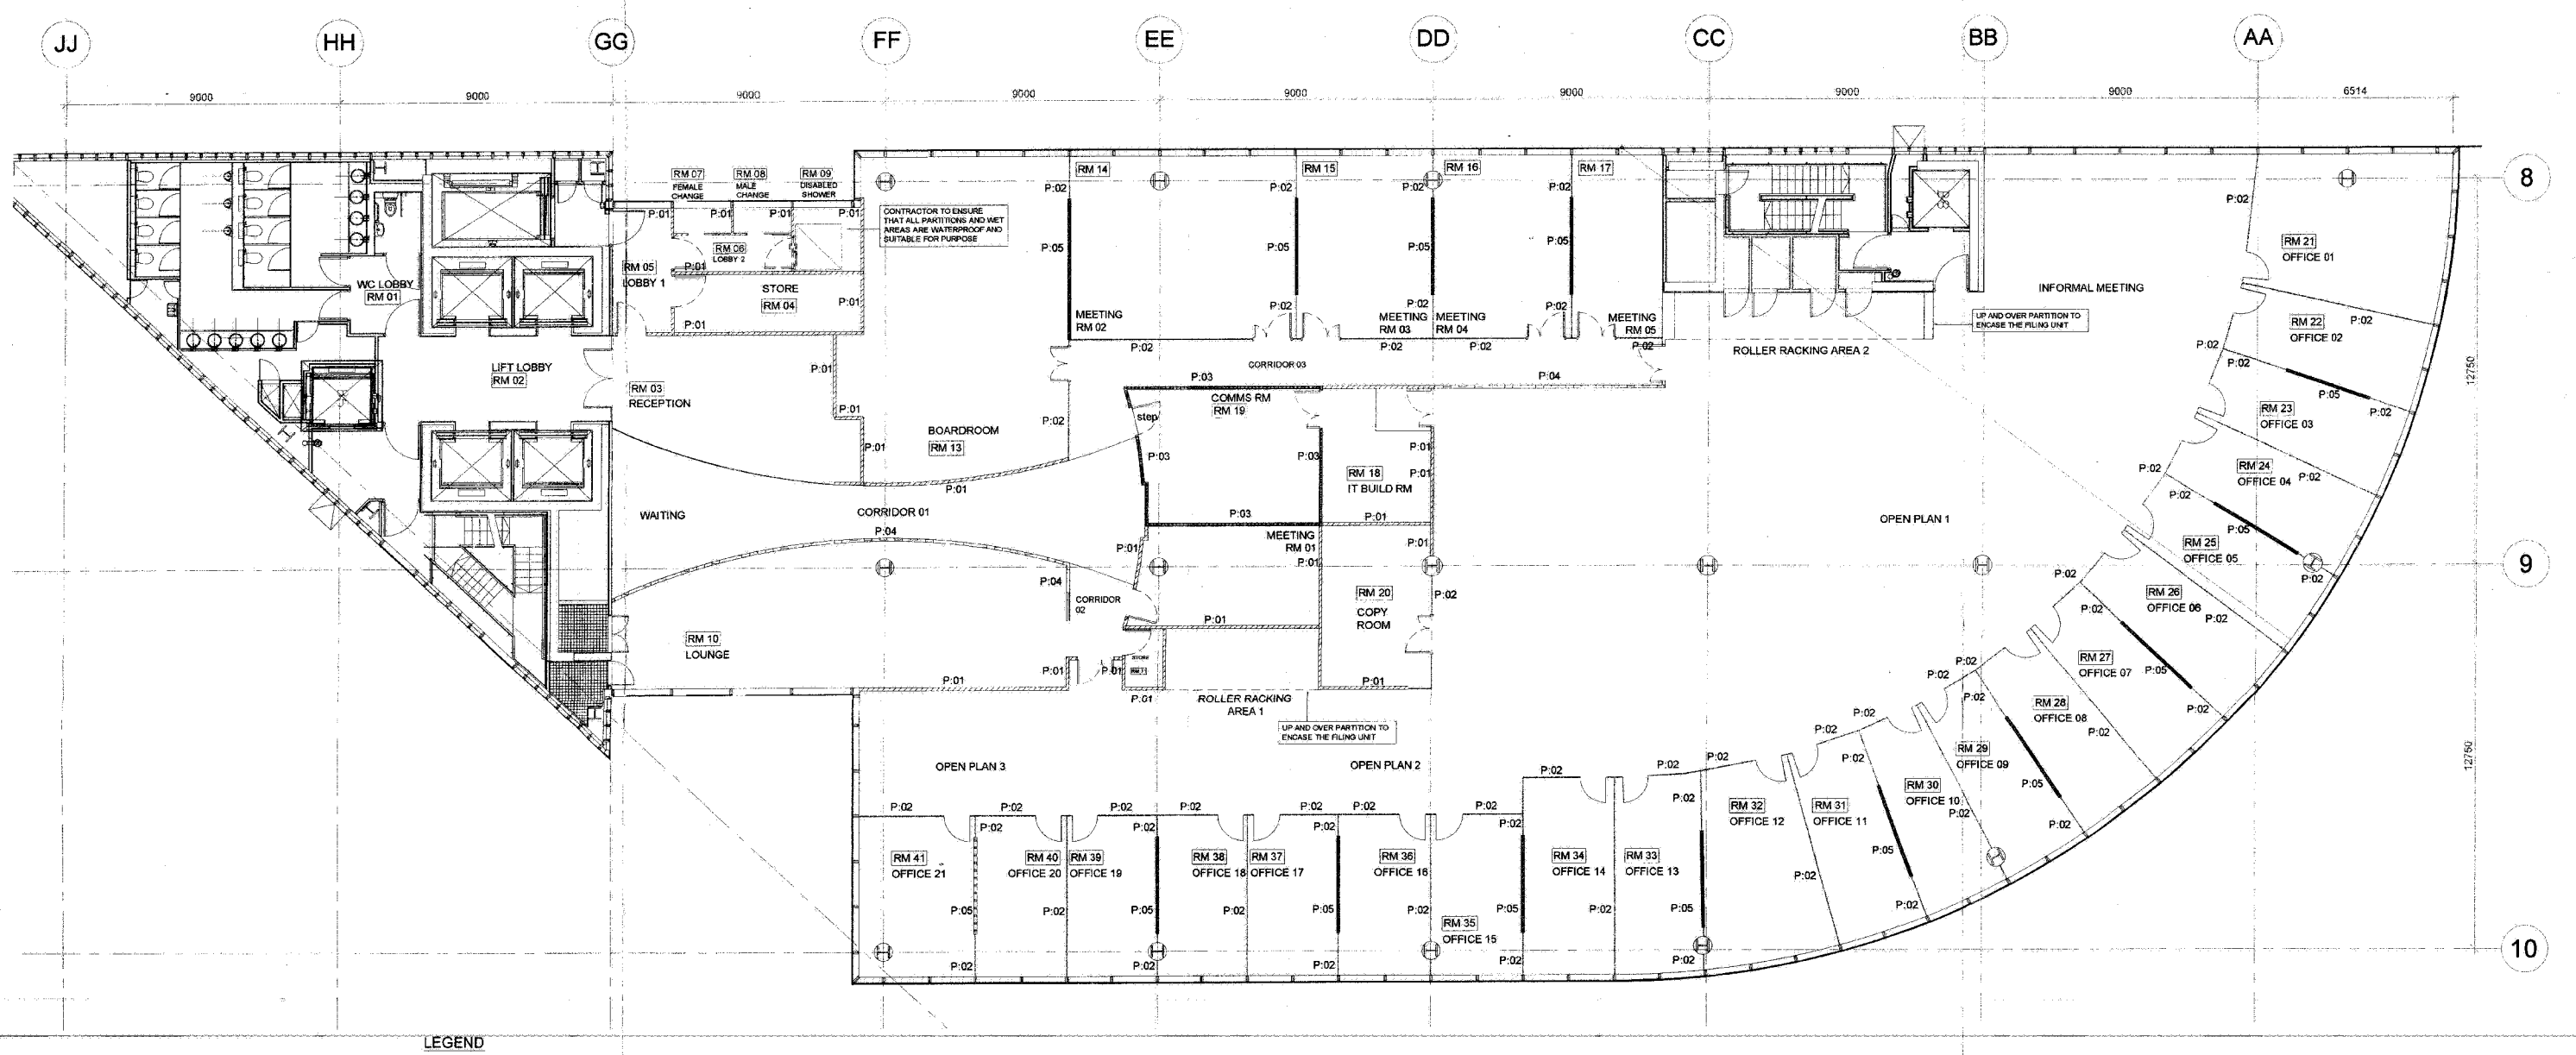

LEGEND

P:01 - FULL HEIGHT SOLID PARTITION

P:02 - FULL HEIGHT GLASS PARTITION

P:03 - 1 HOUR FIRE RATED SOLID PARTITION

P:04 - LUXCRETE GLASS BLOCK WALL (FULL HEIGHT)

P:05 - 1900 HIGH SOLID PARTITION - GLASS ABOVE SOLID PARTITION - TO CEILING LEVEL

Notes

1. Do not scale to ascertain dimensions
2. All dimensions to be checked and verified on site prior to commencement of work
3. This drawing to be read in conjunction with the specification and other drawings
4. Copyright for all designs and drawings in whole or in part shall remain with the Surveyors in accordance with The Copyright Act.

REV	DATE	DESCRIPTION	INITIALS

REV	DATE	DESCRIPTION	INITIALS

REV	DATE	DESCRIPTION	INITIALS

REV	DATE	DESCRIPTION	INITIALS

DATE PLOTTED :
DGN FILENAME : S:/GARY LAGDON/CURRENT JOBS/(NK DENHAM)/MONTAGU PRIVATE EQUITY/THIRD FLOOR
SAVED VIEW NAME :
XREFERENCES :
PLOT No :

DTZ Debenham Tie Leung
International Property Advisors

3-5 Swallow Place, London W1A 4NA
Tel: 020 7408 1161 Fax: 020 7493 0937

CLIENT MONTAGU PRIVATE EQUITY

PROJECT 2 MORE LONDON
THIRD FLOOR

DRAWING PROPOSED PARTITION LAYOUT

DRWG No. 06012265 305

CAD REF:


SCALE: 1:100

DATE: 25 SEPTEMBER 2006

DRAWN: CAL

APPROVED:

REVISION:

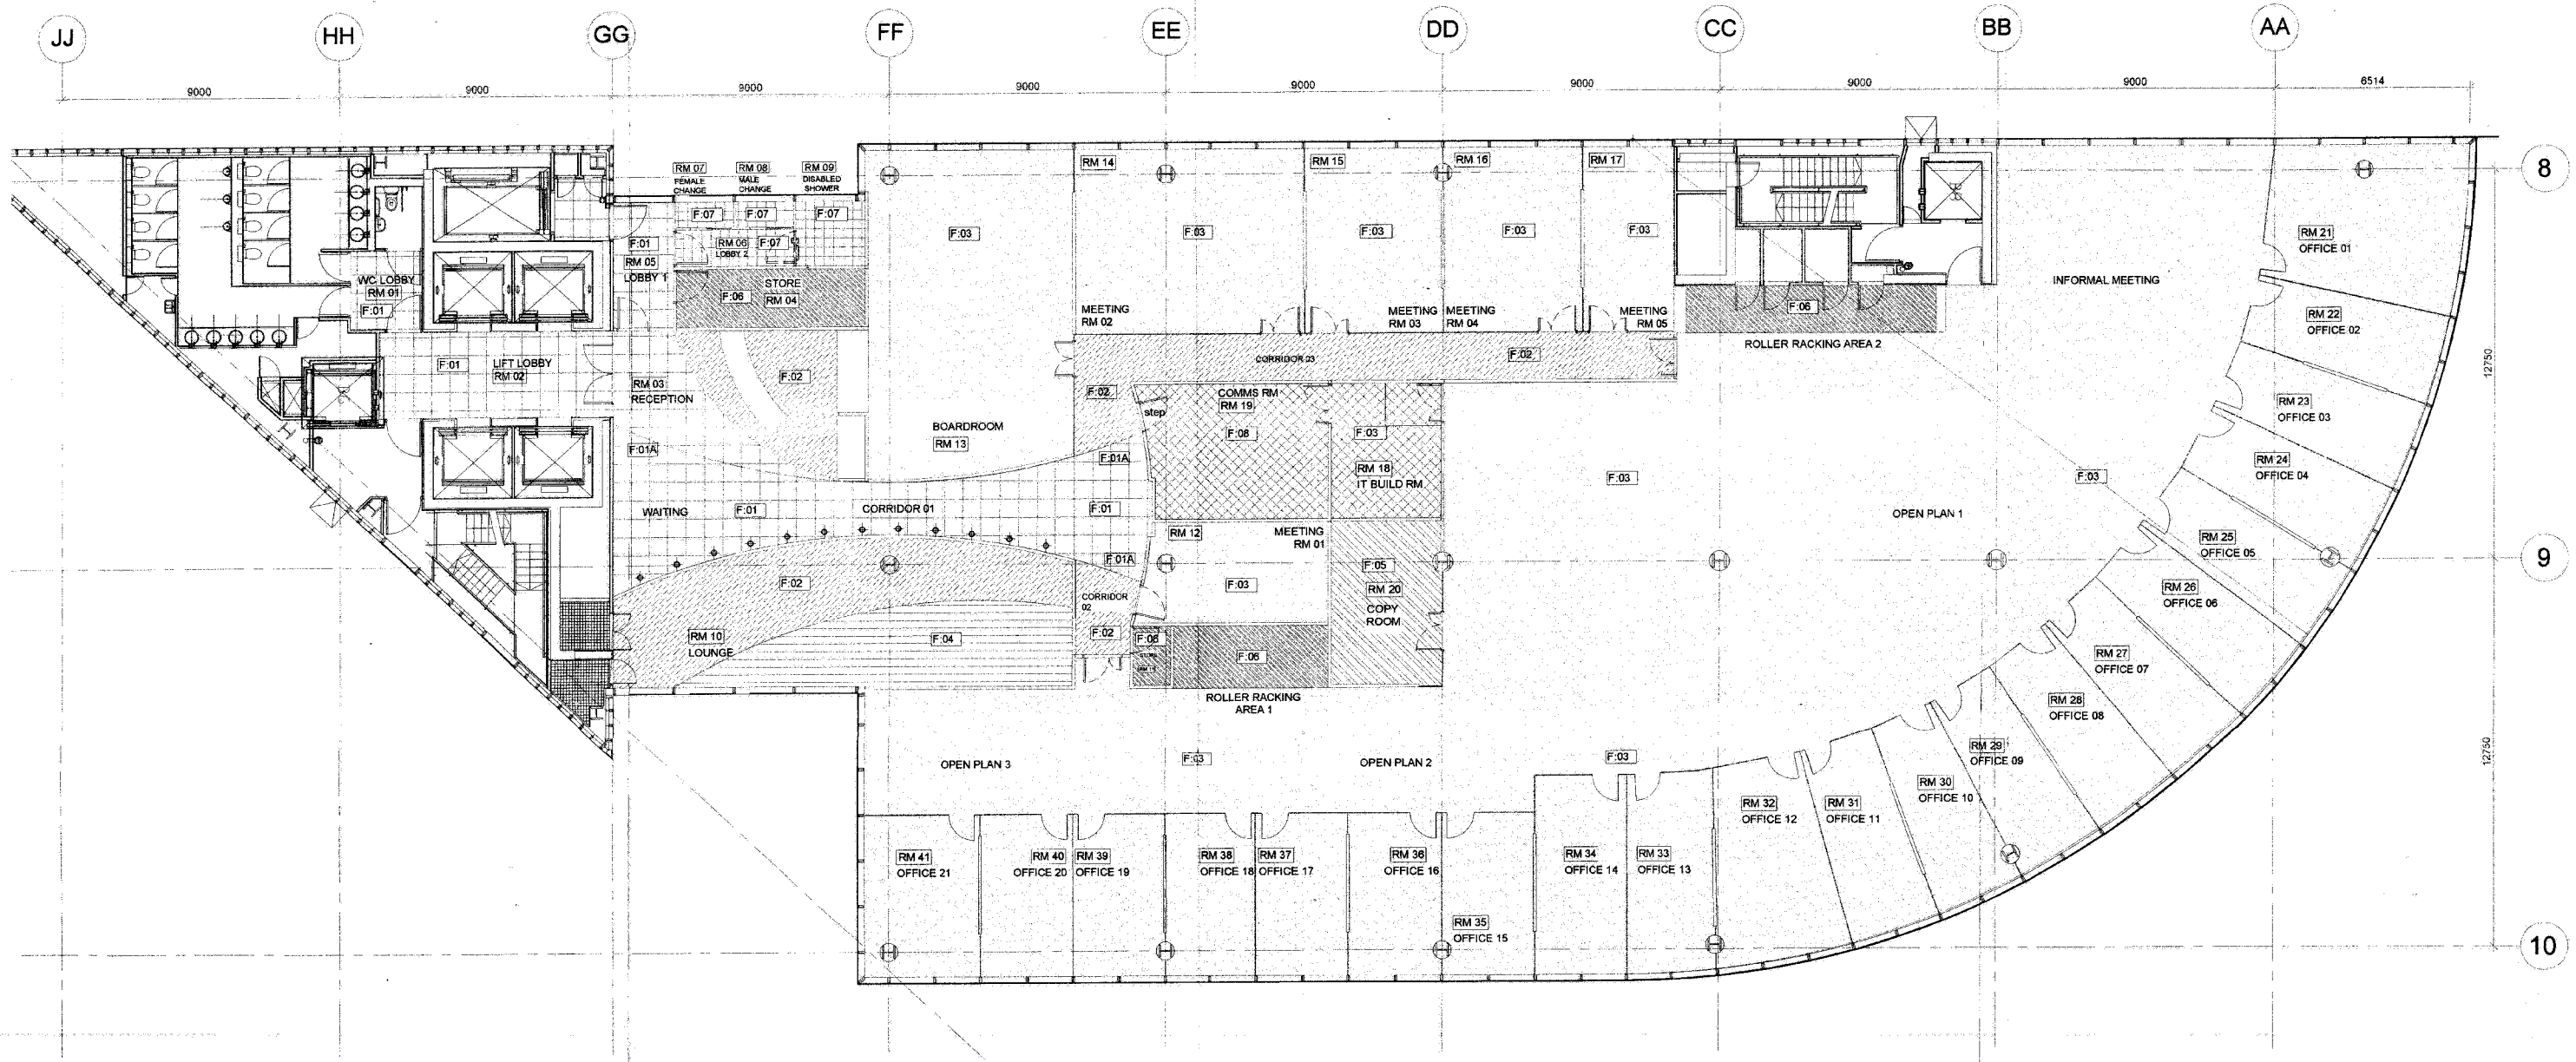

LEGEND:

F:01	-	CERAMIC STONE EFFECT FLOOR FINISH
F:01A	-	STAINLESS STEEL INLAY STRIP
F:02	-	FRONT OF HOUSE CARPET
F:03	-	CARPET TO GENERAL OFFICES, BOARDROOM AND MEETING ROOMS
F:04	-	AMTICO TIMBER EFFECT FLOOR FINISH
F:05	-	VINYL FLOOR COVERING TO COPY
F:06	-	VINYL FLOOR FINISH TO STORE ROOM AND BELOW ROLLER RACKING
F:07	-	CERAMIC FLOOR TILE TO SHOWER & CHANGE AREA
F:08	-	RAISED ANTI-STATIC FLOOR TO COMMS ROOM
⊕		RECESSED FLOOR INDICATOR LIGHT : STAINLESS STEEL WITH OPAL GLASS

Notes

1. Do not scale to ascertain dimensions
2. All dimensions to be checked and verified on site prior to commencement of work
3. This drawing to be read in conjunction with the specification and other drawings
4. Copyright for all designs and drawings in whole or in part shall remain with the Surveyors in accordance with The Copyright Act.


REV	DATE	DESCRIPTION	INITIALS

DATE PLOTTED :
DOS FILENAME : S:/GARY LAGDON/CURRENT JOBS/(NK DENHAM)/MONTAGU PRIVATE EQUITY/THIRD FLOOR
SAVED VIEW NAME :
XREFERENCES :
PLOT No :

DTZ Debenham Tie Leung
International Property Advisors
5-5 Swallow Place, London W1A 4NA
Tel: 020 7408 1161 Fax: 020 7493 0857

CLIENT MONTAGU PRIVATE EQUITY
PROJECT 2 MORE LONDON THIRD FLOOR
DRAWING PROPOSED FLOOR FINISHES
DRWG No. 06012265 3.06
CAD REF:

SCALE: 1:100
DATE: 25 SEPTEMBER 2006
DRAWN: CJL
APPROVED:
REVISION: -

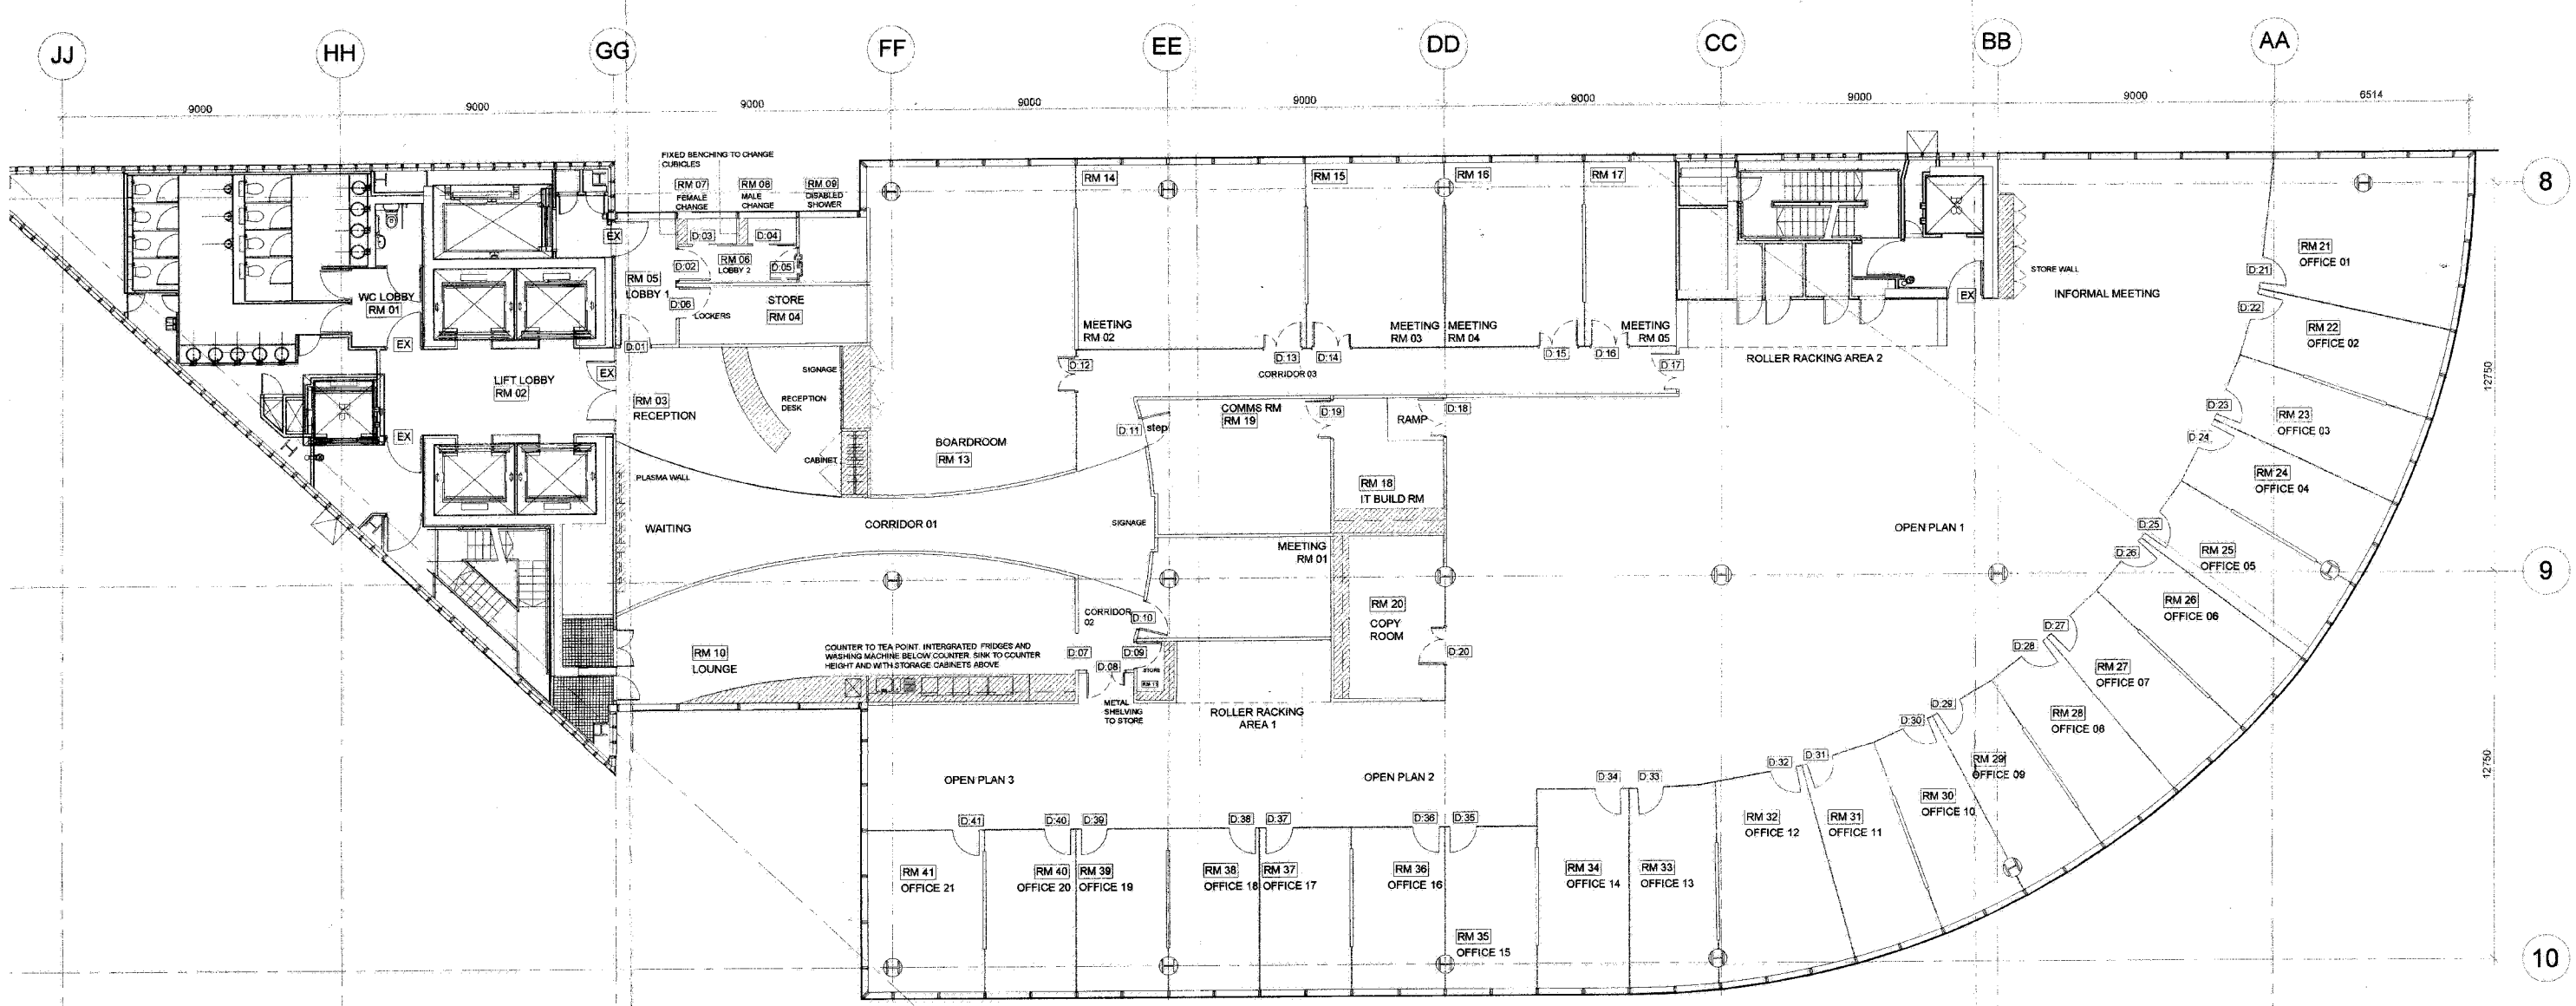

LEGEND

D:00 DOOR REFERENCE

EX EXISTING DOOR (TO BE REFURBISHED)

JOINERY ITEM

Notes

1. Do not scale to ascertain dimensions
2. All dimensions to be checked and verified on site prior to commencement of work
3. This drawing to be read in conjunction with the specification and other drawings
4. Copyright for all designs and drawings in whole or in part shall remain with the Surveyors in accordance with The Copyright Act.

REV	DATE	DESCRIPTION	INITIALS

REV	DATE	DESCRIPTION	INITIALS

REV	DATE	DESCRIPTION	INITIALS

REV	DATE	DESCRIPTION	INITIALS

DATE PLOTTED :
DOS FILENAME : S:/GARY LAGDON/CURRENT JOBS/(NIK DENMAN)/MONTAGU PRIVATE EQUITY/THIRD FLOOR
SAVED VIEW NAME:
XREFERENCES :
PLOT No. :

DTZ Debenham Tie Leung
International Property Advisors

3-5 Stratton Place, London W1A 4NA
Tel: 020 7408 1161 Fax: 020 7493 0837

CLIENT: MONTAGU PRIVATE EQUITY

PROJECT: 2 MORE LONDON
THIRD FLOOR

DRAWING: PROPOSED DOOR & JOINERY LAYOUT

DRWG No. 06072265 CAD REF. 3.07


SCALE: 1:100

DATE: 25 SEPTEMBER 2006

DRAWN:

APPROVED:

REVISION:

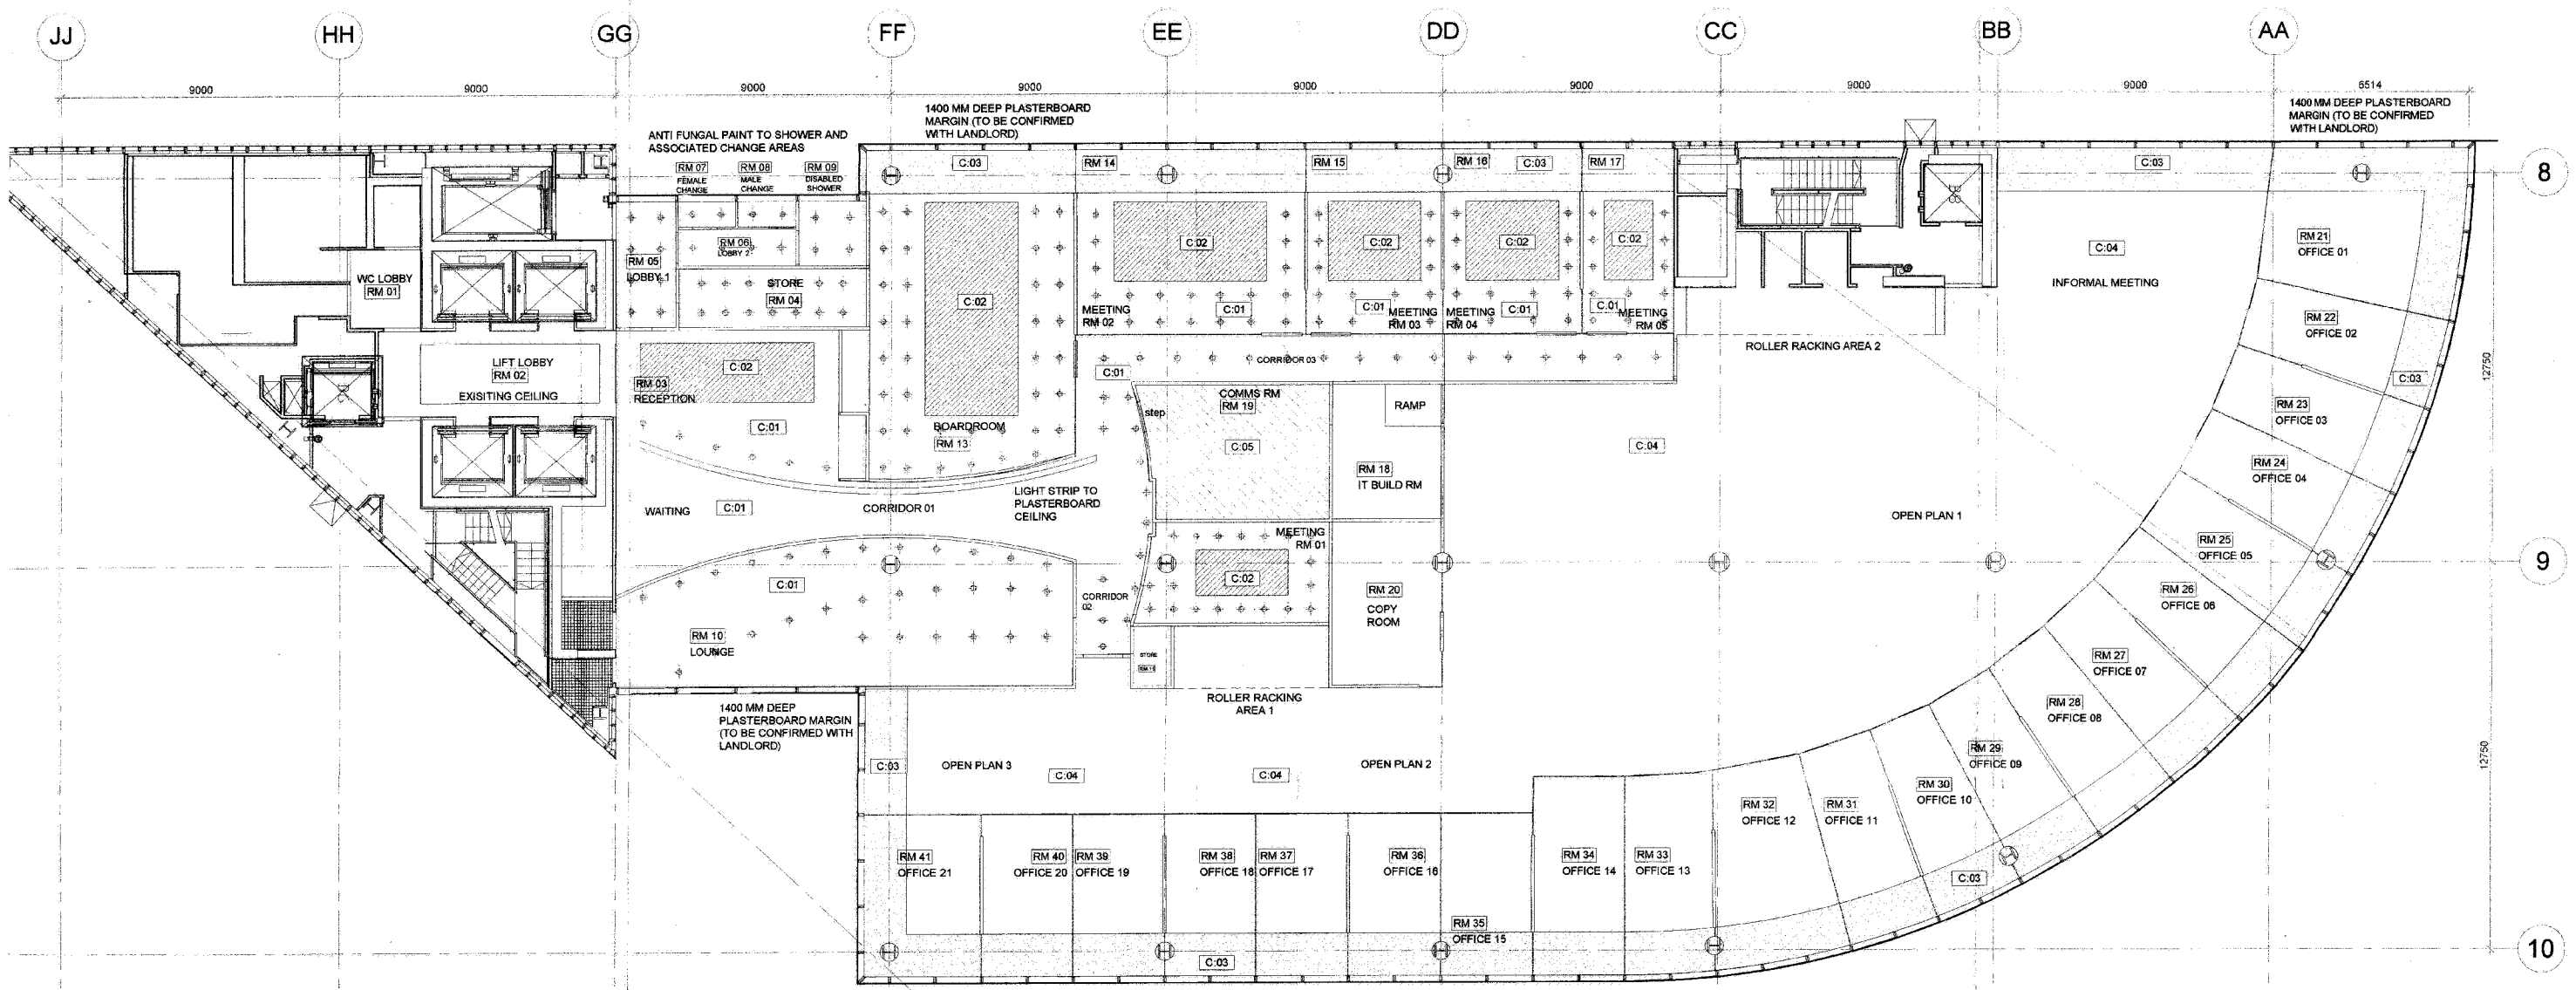

NOTE:
CAT A CEILING SYSTEM
THE CEILING WILL NEED TO ACHIEVE THE FOLLOWING CRITERIA:

- A MINIMUM LIGHT REFLECTANCE OF 75%
- A SOUND ABSORBTION PERFORMANCE ACHIEVING AN NRCC OF 0.70
- THE CEILING CONSTRUCTION WILL BE DESIGNED TO PROVIDE AN ATTENUATED SOUND PATH COMMENSURATE WITH 20 - 25 LBD - IN THE ABSEMSE OF CEILING BARRIER
- THE CEILING VOID WILL ACT AS A RETURN AIR PLENUM

FOR CEILING SPECIFICATION PLEASE REFER TO EMPLOYERS REQUIREMENT DOCUMENT, FINISHES SCHEDULE AND LANDLORDS CAT A SPECIFICATION

LEGEND:
C:01 - PLASTERBOARD CEILING WITH ACCESS PANELS
C:02 - BARRISOL LIGHT SOLUTION
C:03 - PLASTERBOARD MARGIN
C:04 - METAL CEILING TILE
C:05 - CEILING TO COMMS ROOOM TO BE LEFT OPEN UP TO SLAB
⊕ - INDICATIVE LIGHTING TO PLASTERBOARD CEILING

Notes
1. Do not scale to ascertain dimensions
2. All dimensions to be checked and verified on site prior to commencement of work
3. This drawing to be read in conjunction with the specification and other drawings
4. Copyright for all designs and drawings in whole or in part shall remain with the Surveyors in accordance with the Copyright Act.

REV	DATE	DESCRIPTION	INITIALS

DATE PLOTTED :
DOS FILENAME : S:/DARY_AGEON/CURRENT JOBS/DNK DENMAN/MONTAGU PRIVATE EQUITY/THIRD FLOOR
SAVED VIEW NAME :
XREFERENCES :
PLOT No :

DTZ Debenham Tie Leung
International Property Advisors
3-5 Swallow Place, London W1A 4NA
Tel: 020 7408 1161 Fax: 020 7493 0937

CLIENT: MONTAGU PRIVATE EQUITY
PROJECT: 2 MORE LONDON THIRD FLOOR
DRAWING: PROPOSED REFLECTED CEILING PLAN
DRWG No. 06012765
CAD REF: 3.08
SCALE: 1:100
DATE: 25 SEPTEMBER 2006
ORIGINAL: A1
APPROVED:
REVISION: